

Name

Service No.

Address

63 Grassland Street

Lot #36

Location

Kind of Pipe

Size

Size of Main

Repair—Renewal—New Service


Location

Date	Material	Amount	Total	Date	Amount
	25' 6" A.C.				
				8-24-73	
				25' 6" Transite	
				1 6" Elbow	
				1 6" Nipple	
				1 6" x 8" Saddle	
				1 6" Cap	

DATE _____

TOWN OF LEXINGTON — BOARD OF PUBLIC WORKS

SEWER DIVISION

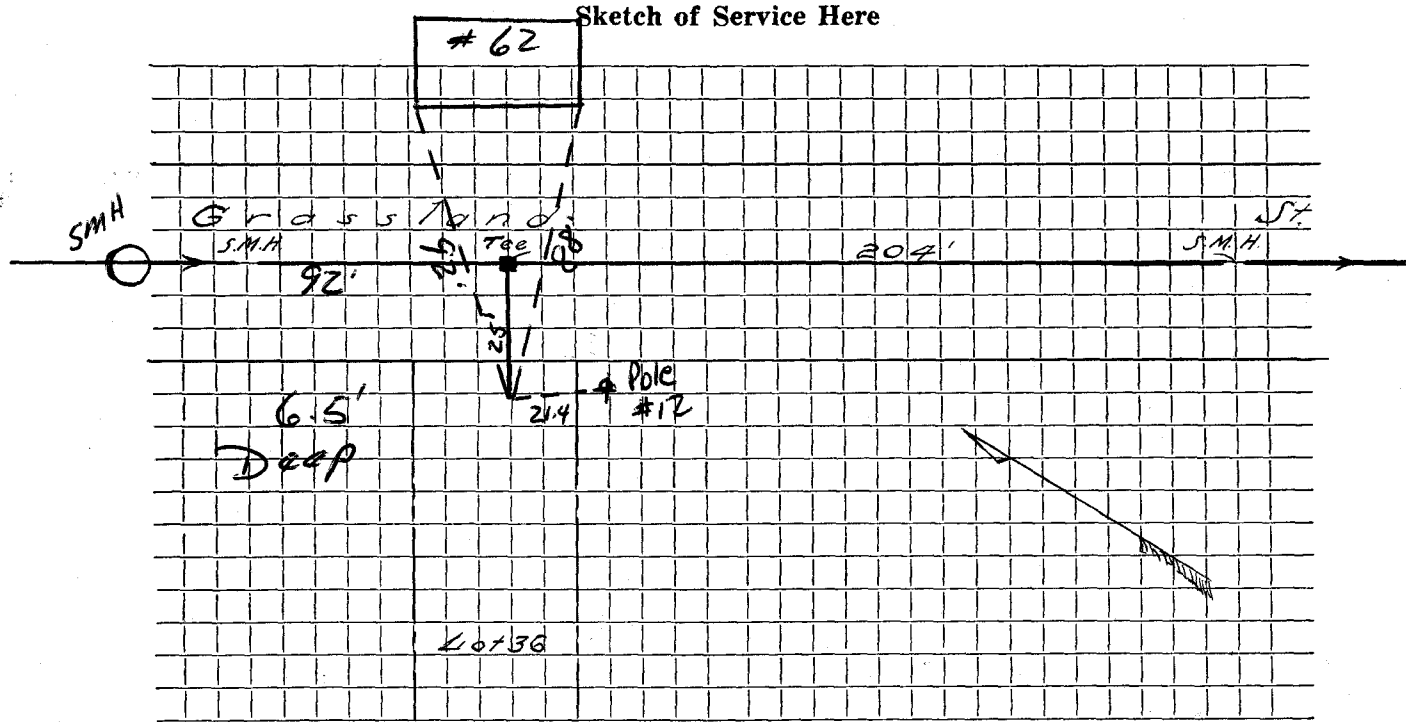

Connection made in Street. Work completed

Remarks:

.....

.....