

Name Donna Realty Trust

Service No. 79

Address 64 Grassland Street

Location

Kind of Pipe

Size

Size of Main

Repair—Renewal—New Service W.O.#6711 Valeri #1432

Location SEP 2 1969


Date	Material	Amount	Total	Date	Amount
8-14-69	Labor	104.52		8-5-69	200.00
	10% O.H.	10.45	114.97	9-3-69	29.80
	28' 6" Transite pipe @.88		24.64		170.20
	1 90° Transite Elbow		4.09	8-14-69	
	3 hrs. Town Sovel @6.50		19.50		28' 6" Transite
	2 hrs. Trucking @1.50		3.00		1 6"-90° Elbow
	4 hrs. Pump @1.00		4.00		
			170.20		
8-21-69	30' 6" Transite pipe				
	27' 6" Transite				
	10' 4" C.I. Pipe				

DATE _____

TOWN OF LEXINGTON — BOARD OF PUBLIC WORKS

SEWER DIVISION

Sketch of Service Here

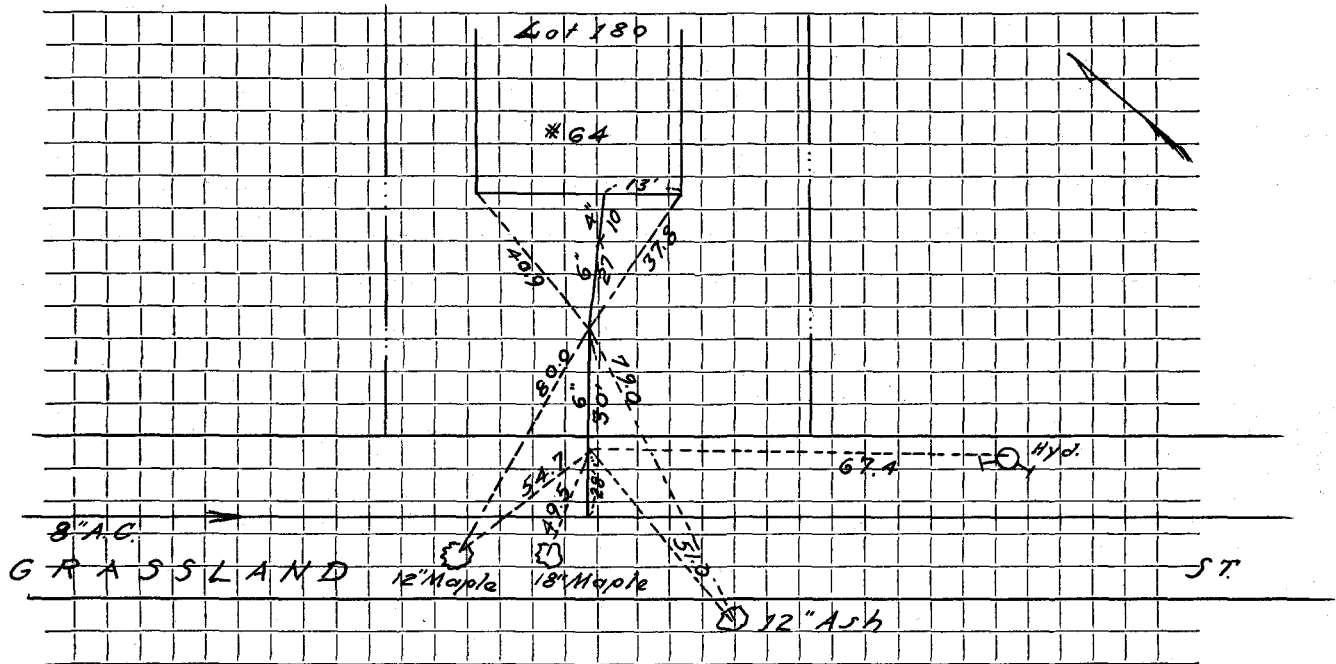

Connection made in Street. Work completed

Remarks:

.....

.....