

Name

Service No.

Address 65 Grassland Street

Lot #37

Location

Kind of Pipe

Size

Size of Main

Repair—Renewal—New Service

Location

Date

Material

Amount

Total

Date

Amount

~~25' 6" TRANS.~~

8-24-73

25' 6" Transite

1 6" Elbow

1 6" Nipple


1 6" x 8" Saddle

1 6" Cap

DATE \_\_\_\_\_

TOWN OF LEXINGTON — BOARD OF PUBLIC WORKS

SEWER DIVISION

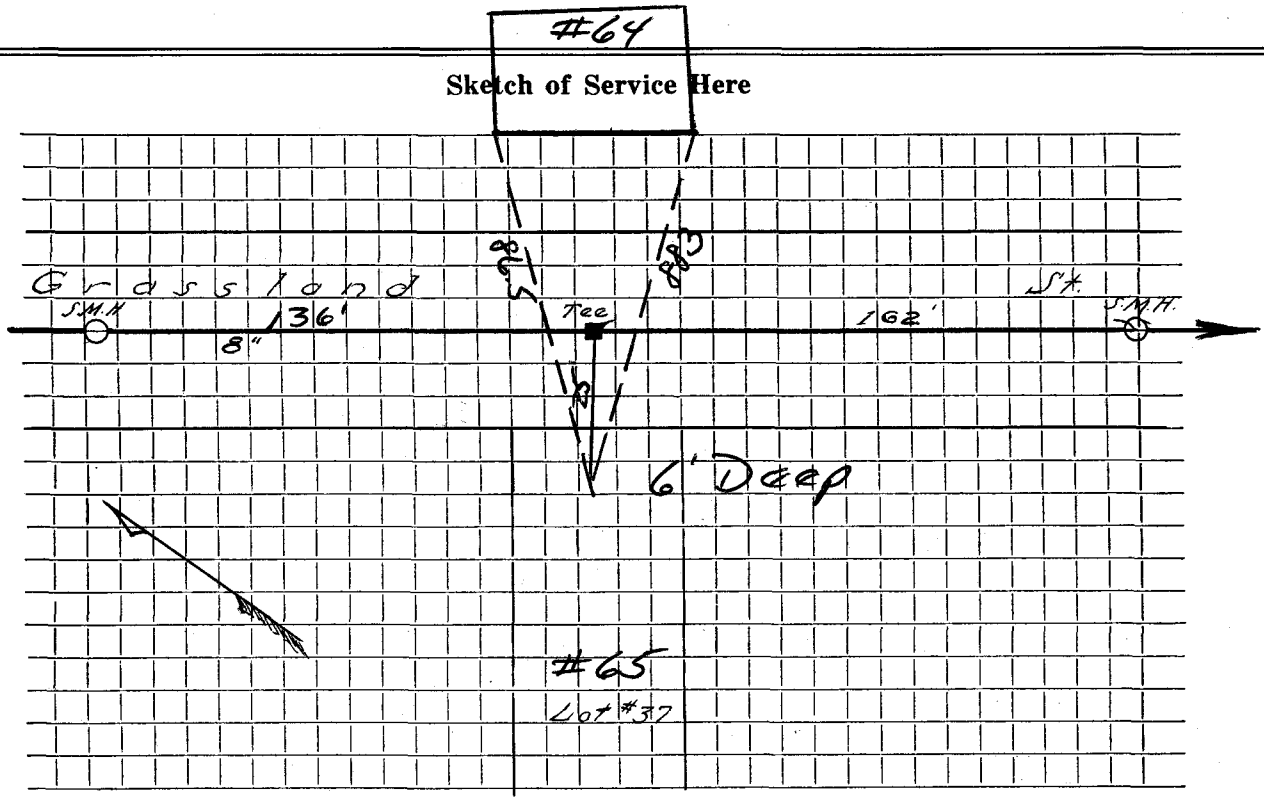

Connection made in ..... Street. Work completed .....

Remarks: .....  
.....  
.....