


DATE 1965

TOWN OF LEXINGTON — BOARD OF PUBLIC WORKS

SEWER DIVISION

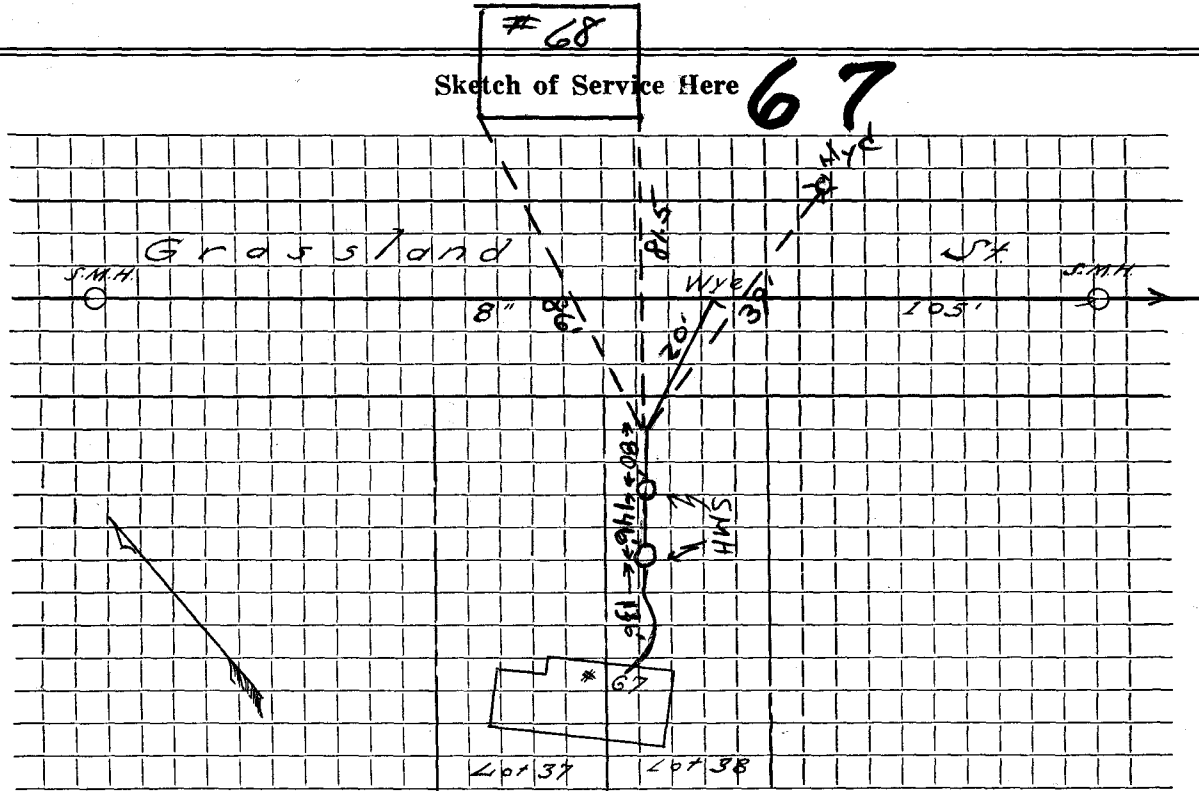

Connection made in GRASSLAND ST Street. Work completed Nov 1983

Remarks:

.....

.....