

Name Daniel L. McCabe

Service No. 50

Address 7 Grassland Street

Lot #13 Pt.14

Location 7 Grassland St. Lot 13 Pt. 14

Kind of Pipe

Size

Size of Main

Repair—Renewal—New Service Sibley #1372

Location SEP 2 1969

Date	Material	Amount	Total	Date	Amount
Jul '66	21' 6" Transite pipe @5.00		105.00	6-3-69	105.00
6-13-69	32' 6" Transite Pipe				
	10' 4" Cast Iron pipe			7- - 66	
				21' 6" Transite	


DATE _____

TOWN OF LEXINGTON — BOARD OF PUBLIC WORKS

SEWER DIVISION

Sketch of Service Here

7

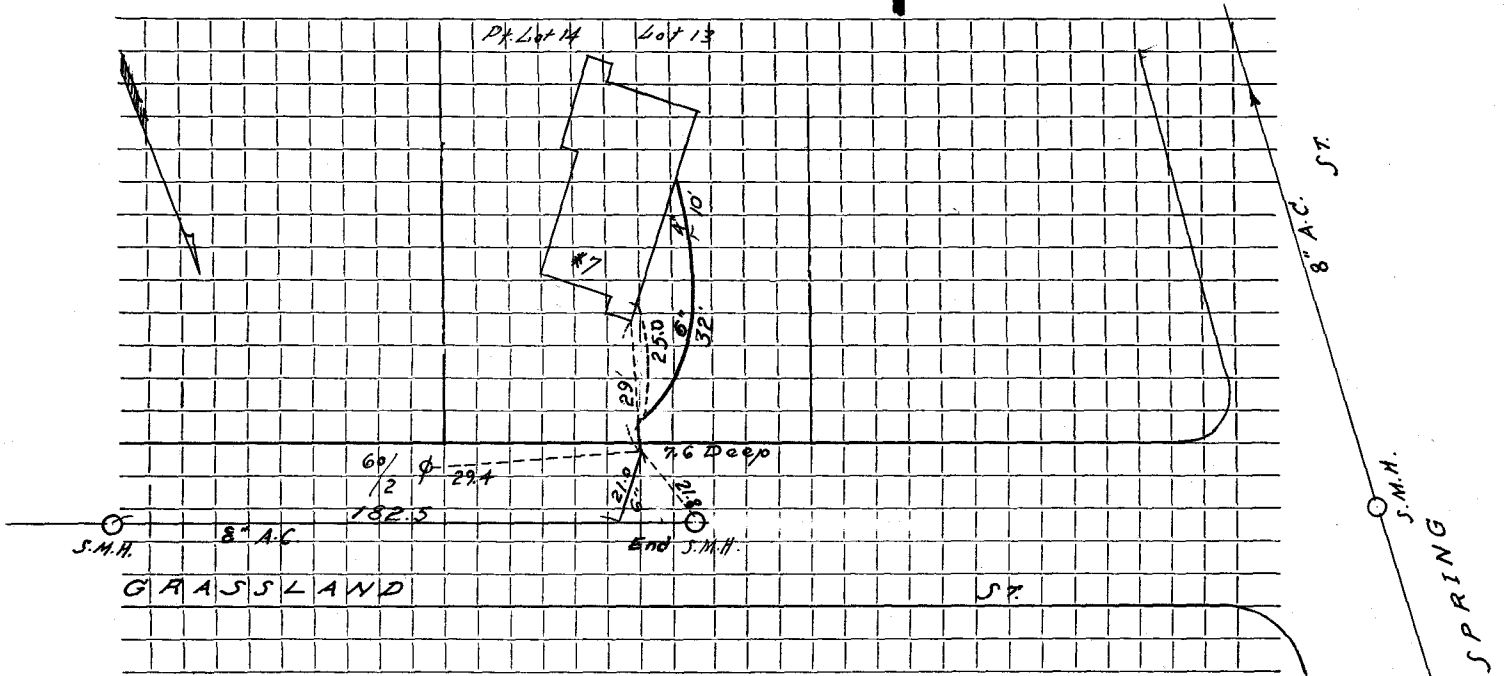

Connection made in Street. Work completed

Remarks:
.....
.....