

Name *Ronald DeMille*

Service No. 22

Address *71 Grassland Street*

Lot#39.

Location

Kind of Pipe

Size

Size of Main

~~Repair~~ **Renewal**—New Service W.O.#1065.Location **OCT 31 1983**


Date	Material	Amount	Total	Date	Amount
8-23-73	Labor	118.52		<i>7-15-83</i>	<i>Deposit</i>
	10% O.H.	11.85	\$130.37		<i>190.19</i>
25	6" Pipe @/90	22.50	22.50		
1	6" Adapter		4.67	<i>8-23-73</i>	
1	6" Elbow			<i>25' 6" Transite</i>	
2	Hrs. Truck @3.00		6.00	<i>1 6" Adapter</i>	
1	Hr. Shovel @6.50		6.50	<i>1 6" Elbow</i>	
2	Hrs. Loader @4.00		8.00		
1	Hr. Town Shovel @6.50		6.50		
			\$190.19		
<i>9/27/83</i>	<i>431' 6" P.V.C.</i>				

DATE _____

TOWN OF LEXINGTON — BOARD OF PUBLIC WORKS
SEWER DIVISION

Sketch of Service Here

71

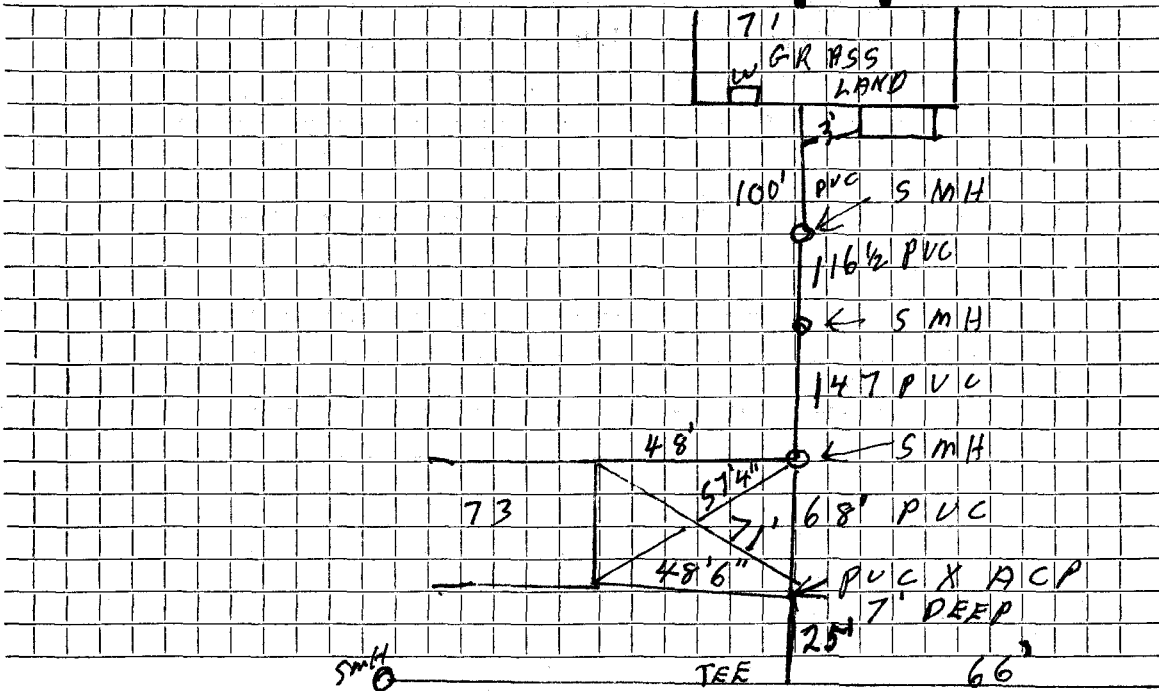

Connection made in Street. Work completed 5 MH

Remarks:
.....
.....