

Name Stratvern Realty

Service No. 12

Address 72 Grassland Street

Location Lot 177

Kind of Pipe

Size

Size of Main

~~Repair~~ ~~Renewal~~ New Service W.O. # 7606 Valeri #1557

Location JUL 27 1970


Date	Material	Amount	Total	Date	Amount
5-4-70	Labor	74 32		4-22-70	Deposit 200 00
	10% O.H.	7 43		7-27-70	Refund 28 10
	15' 6" Transite pipe .90	13 50			171 90
	1 90° Elbow	5 65		5-4-70	
	1 6" Plug	3 80			15' 6" Transite
	1 Load stone	13 20			1 6"-90° Elbow
	2 Loads gravel 14.00	28 00			1 6" Plug
	2 Hrs. shovel 6.50	13 00			
	1 Hr. loader	5 00			
	2 Hrs. trucking 3.00	6 00			
	2 Hrs. pump 1.00	2 00			
		171 90			
6-2-70	28' 6" Transite pipe				
	10' 4" Cast Iron pipe				

DATE _____

TOWN OF LEXINGTON — BOARD OF PUBLIC WORKS

SEWER DIVISION

Sketch of Service Here **72**

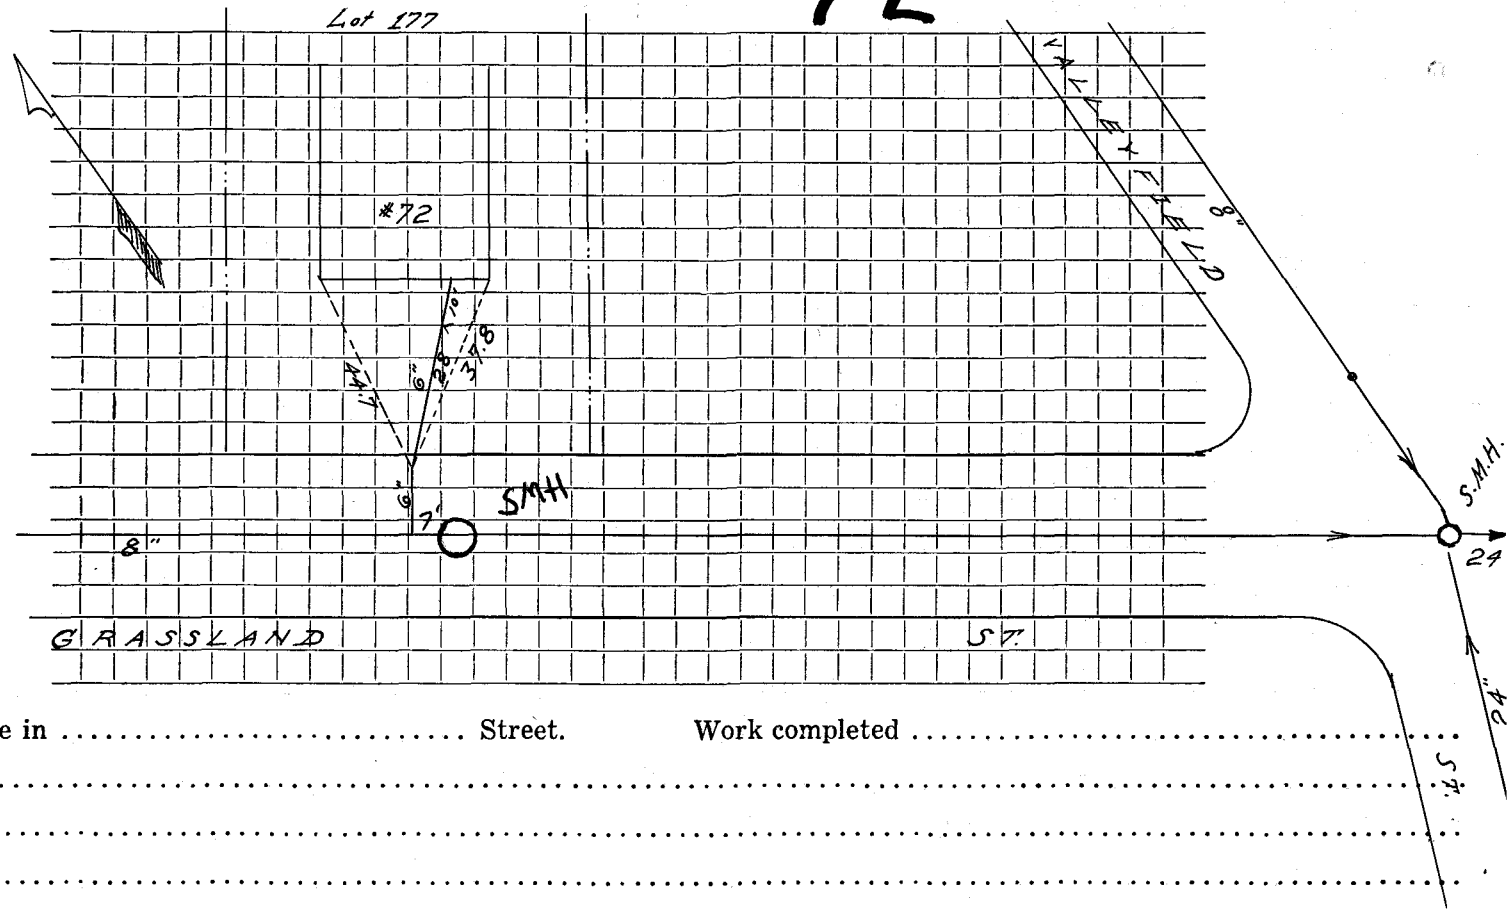

Connection made in Street. Work completed

Remarks:
.....
.....