

Name Barbara DeMille

Service No. 93

Address 73 Grassland Street

Location Lot#40.

Kind of Pipe

Size

Size of Main

~~Repair-Renewal~~—New Service W.O.#1067. DeFlice #3204

Location DEC 26 1978

Date	Material	Amount	Total	Date	Amount	
8-23-73	Labor	150.45		11-14-78	Deposit	366.39
	10% O.H.	15.05	\$165.50			
	25' 6" Pipe @.90		22.50	8-23-73		
	4 6" Collars @1.88		7.52	25'	6" Transite	
	1 6" Elbow		5.65	1	6" Elbow	
	1 6" Close Nipple		1.55	1	6" Close Nipple	
	1 6" x 8" Saddle		11.97	1	6" x 8" Saddle	
	10 Ton 1½ Stones @3.50		35.00			
	30 Yds. Gravel @2.19		65.70			
	1 Hr. Pickup		1.50			
	4 Hrs. Truck @3.00		12.00			
	2 Hrs. Loader @4.00		8.00			
	3 Hrs. Town Shovel @6.50		19.50			
	<i>PREVIOUS CHARGE \$366.39</i>					
11/30/78	29' 6" Transite Pipe					
	10' 4" Cast Iron Pipe					


DATE _____

TOWN OF LEXINGTON — BOARD OF PUBLIC WORKS

SEWER DIVISION

Sketch of Service Here

73

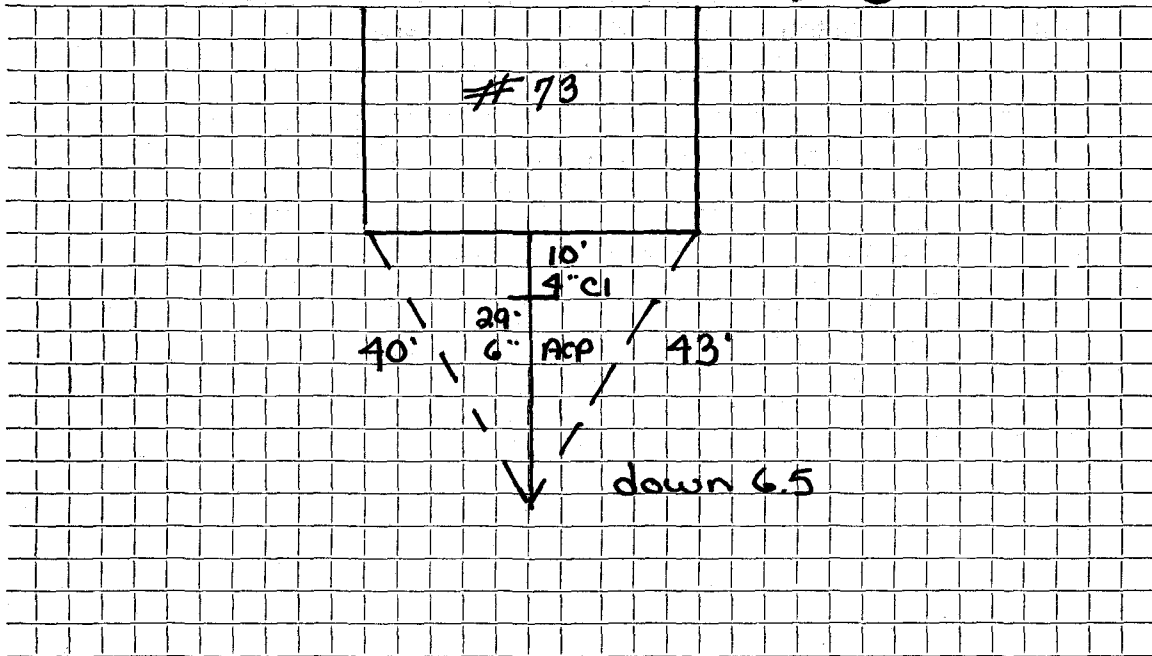

Connection made in Street. Work completed

Remarks:
.....
.....