

Name

Service No.

Address 74 Grassland Street

Lot #176

Location

Kind of Pipe

Size

Size of Main

Repair—Renewal—New Service

Location


Date	Material	Amount	Total	Date	Amount
10-2-69	25' 6" Transite				
	10' 4" C.I. Pipe			9-23-69	
				25' 6" Transite	
				1 6"-90° Elbow	
				1 6" Plug	

DATE \_\_\_\_\_

TOWN OF LEXINGTON — BOARD OF PUBLIC WORKS

SEWER DIVISION

Sketch of Service Here **74**

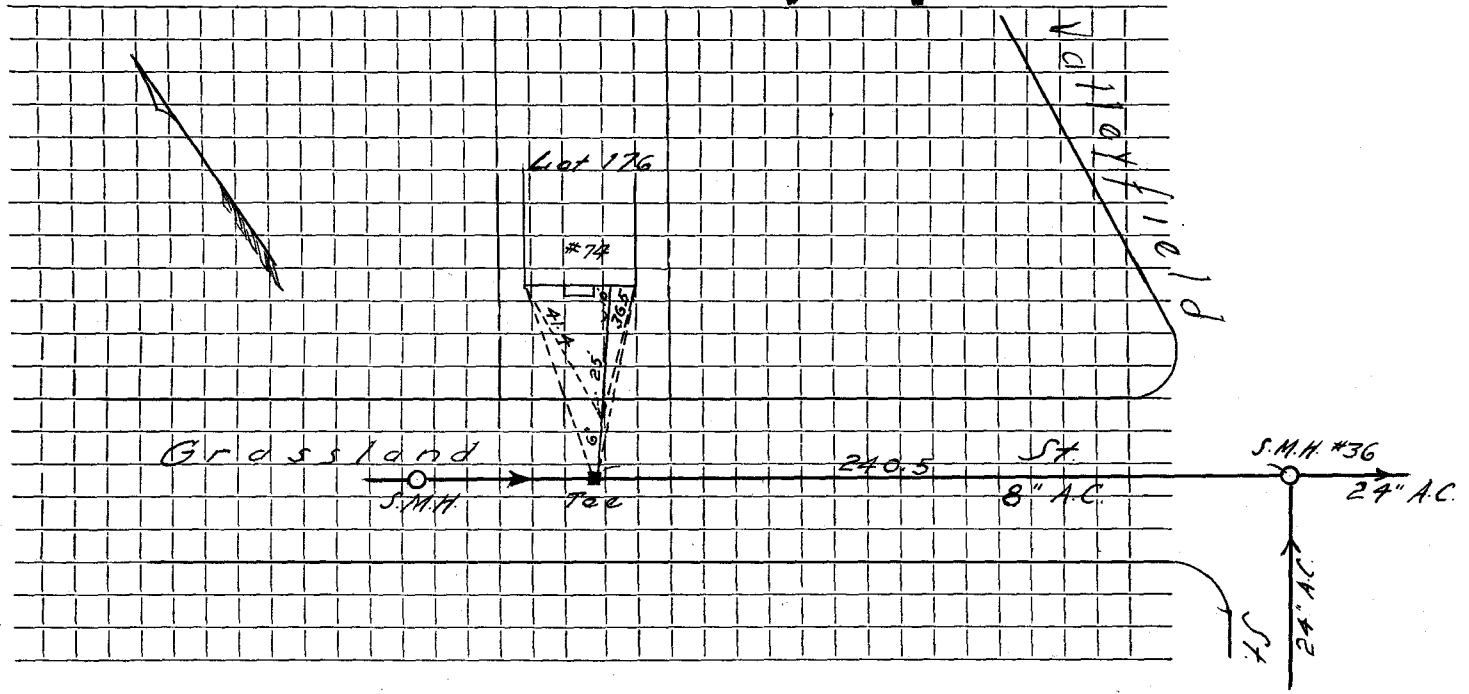

Connection made in ..... Street. Work completed .....

Remarks: .....  
.....  
.....