

Name Antonio Gaira

Service No. 108

Address 75 Grassland Street

Location

Kind of Pipe

Size

Size of Main

Repair—Renewal—New Service

W.O. #1071 Valeri #3136

Location NOV 19 1973

Date	Material	Amount	Total	Date	Amount
8/22/73	Labor	150.00		9-11-73	386.72
	10% O.H.	15.00	165.00		
25'	6" Pipe @.90		22.50		
4	6" Couplings @1.88		7.52	8-22-73	
1	6" Elbow		5.65	25' 6" Transite	
1	6" Close Nipple		1.55	1 6" Elbow	
1	6 x 8 Saddle		5.50	1 6" Close Nipple	
10	ton 1½" Stone @3.00	30.00	30.00	1 6" x 8" Saddle	
30	yds Gravel @2.19		63.00		
5	hrs. Trucking @3.00		15.00		
2	hrs. Loader @4.00		8.00		
3	hrs. Town Shovel @6.50		63.00		
			386.72		
9/13/73	40' 6" Transite pipe				
	10' 4" Cast Iron pipe				


DATE _____

TOWN OF LEXINGTON — BOARD OF PUBLIC WORKS

SEWER DIVISION

Sketch of Service Here

75

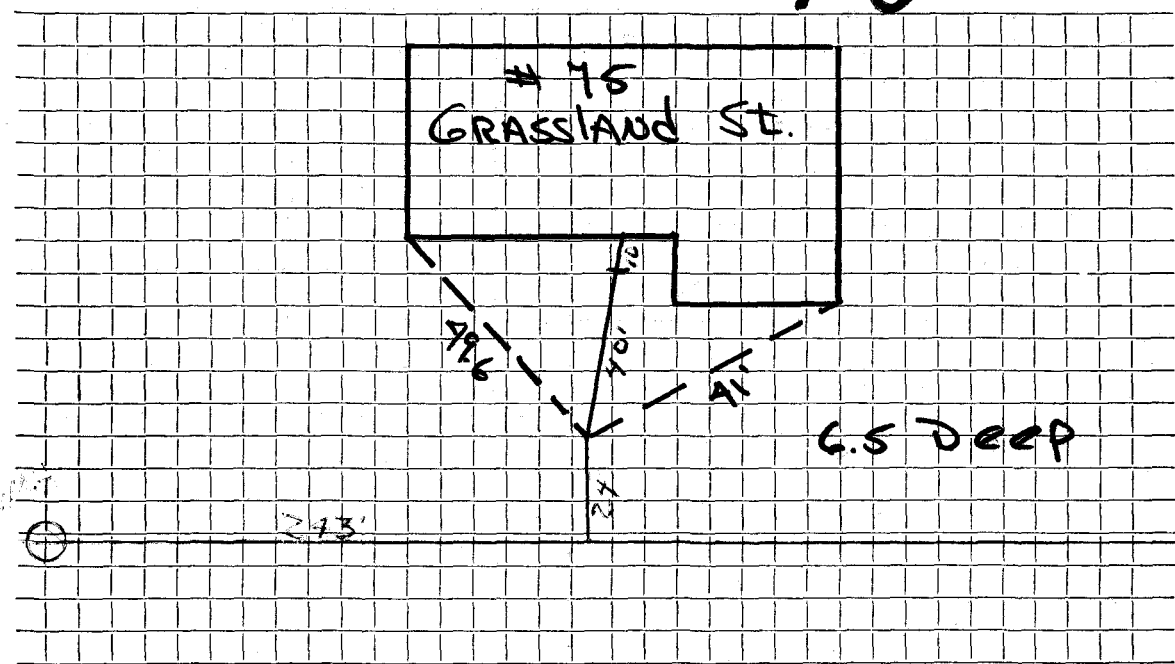

Connection made in Street. Work completed

Remarks:
.....
.....