

Name Stratvern Realty

Service No. 13

Address 76 Grassland Street

Location Lots 175 &amp; Pt. 174

Kind of Pipe

Size

Size of Main

~~Repair~~ New Service W.O. # 7608


Valeri #1558

Location JUL 27 1970

| Date              | Material              | Amount | Total  | Date    | Amount       |        |
|-------------------|-----------------------|--------|--------|---------|--------------|--------|
| <del>5-4-70</del> | Labor                 | 92 90  |        | 4-22-70 | Deposit      | 300 00 |
|                   | 10% O.H.              | 9 29   | 102 19 | 7-27-70 | Retard       | 21 41  |
| 15'               | 6" Transite pipe .90  |        | 13 50  |         |              | 178 39 |
| 1                 | 90° Elbow             |        | 5 65   | 5-4-70  |              |        |
| 1                 | 6" Plug               |        | 3 85   | 15'     | 6" Transite  |        |
| 1                 | Load stone            |        | 13 20  | 1       | 6"-90° Elbow |        |
| 1                 | Load gravel           |        | 14 00  | 1       | 6" Plug      |        |
| 2                 | Hrs. shovel 6.50      |        | 13 00  |         |              |        |
| 2                 | " trucking 3.00       |        | 6 00   |         |              |        |
| 1                 | " loader              |        | 5 00   |         |              |        |
| 2                 | " pump 1.00           |        | 2 00   |         |              |        |
|                   |                       |        | 178 39 |         |              |        |
| 6-2-70            | 28' 6" Transite pipe  |        |        |         |              |        |
|                   | 10' 4" Cast Iron pipe |        |        |         |              |        |

DATE \_\_\_\_\_

TOWN OF LEXINGTON — BOARD OF PUBLIC WORKS  
SEWER DIVISION

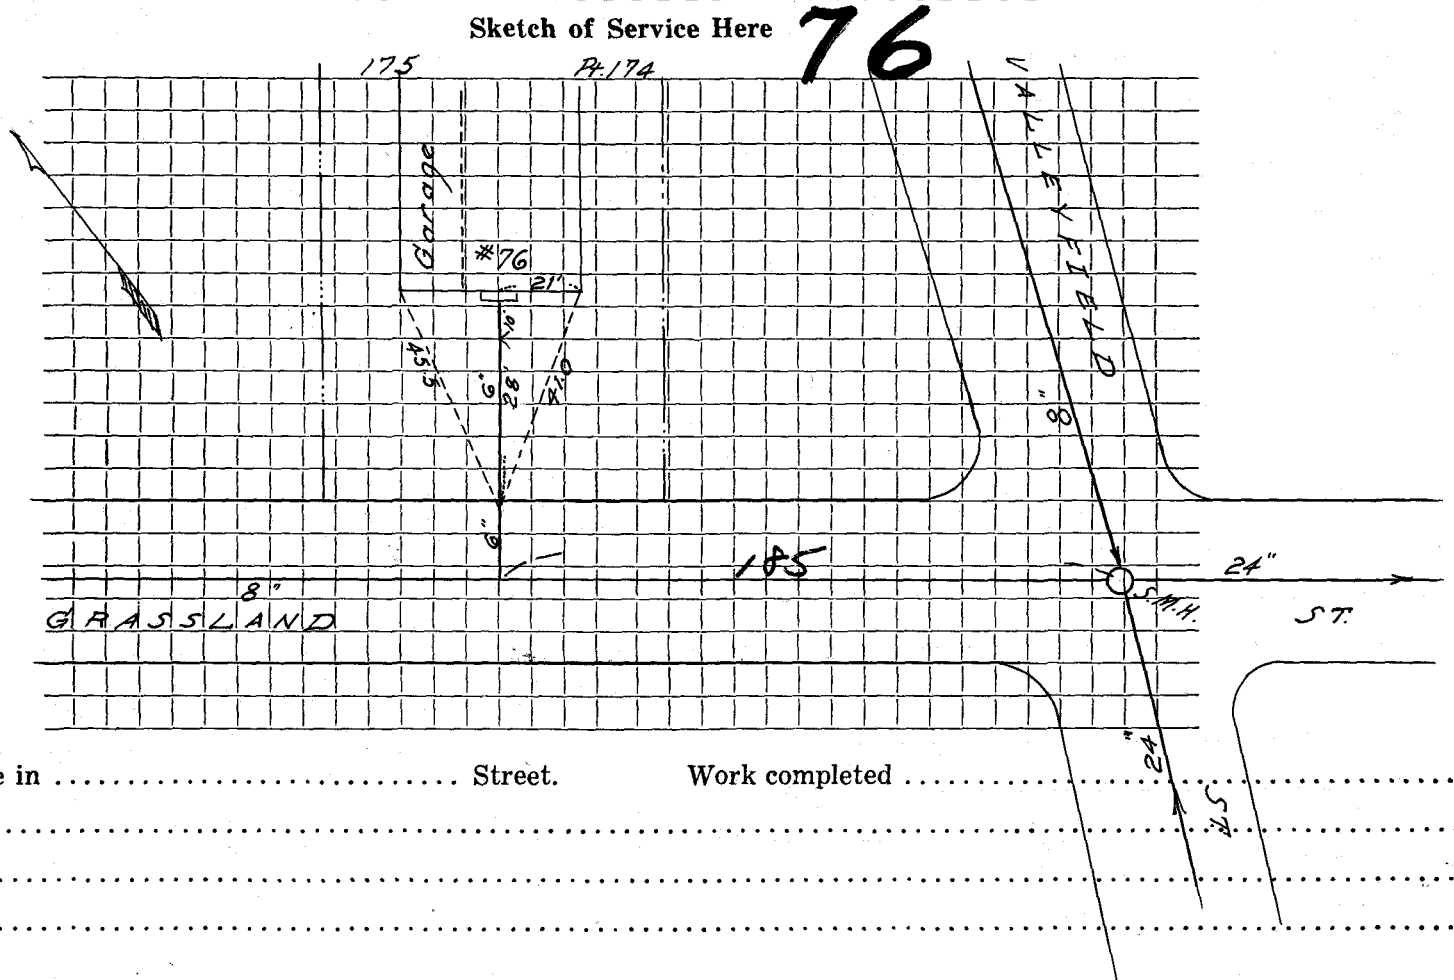

Connection made in ..... Street. Work completed .....

Remarks: .....  
.....  
.....