

Name Jeffrey D. Carter

Service No.

Address 451 GREAT ROAD (ON LEX. TOWN SEWER)

Location

Kind of Pipe

Size

Size of Main

Repair—Renewal—New Service

Bob Gaylor, Inc. #0731

Location

Date

Material

Amount

Total

Date

Amount

1/5/96

2 SMH


172 LF 6" PVC

22° ELBOW

WYE CLEANOUT

TOWN OF LEXINGTON — BOARD OF PUBLIC WORKS
SEWER DIVISION

DATE _____
451 ~~BED~~ GREAT ROAD
BEDFORD MA

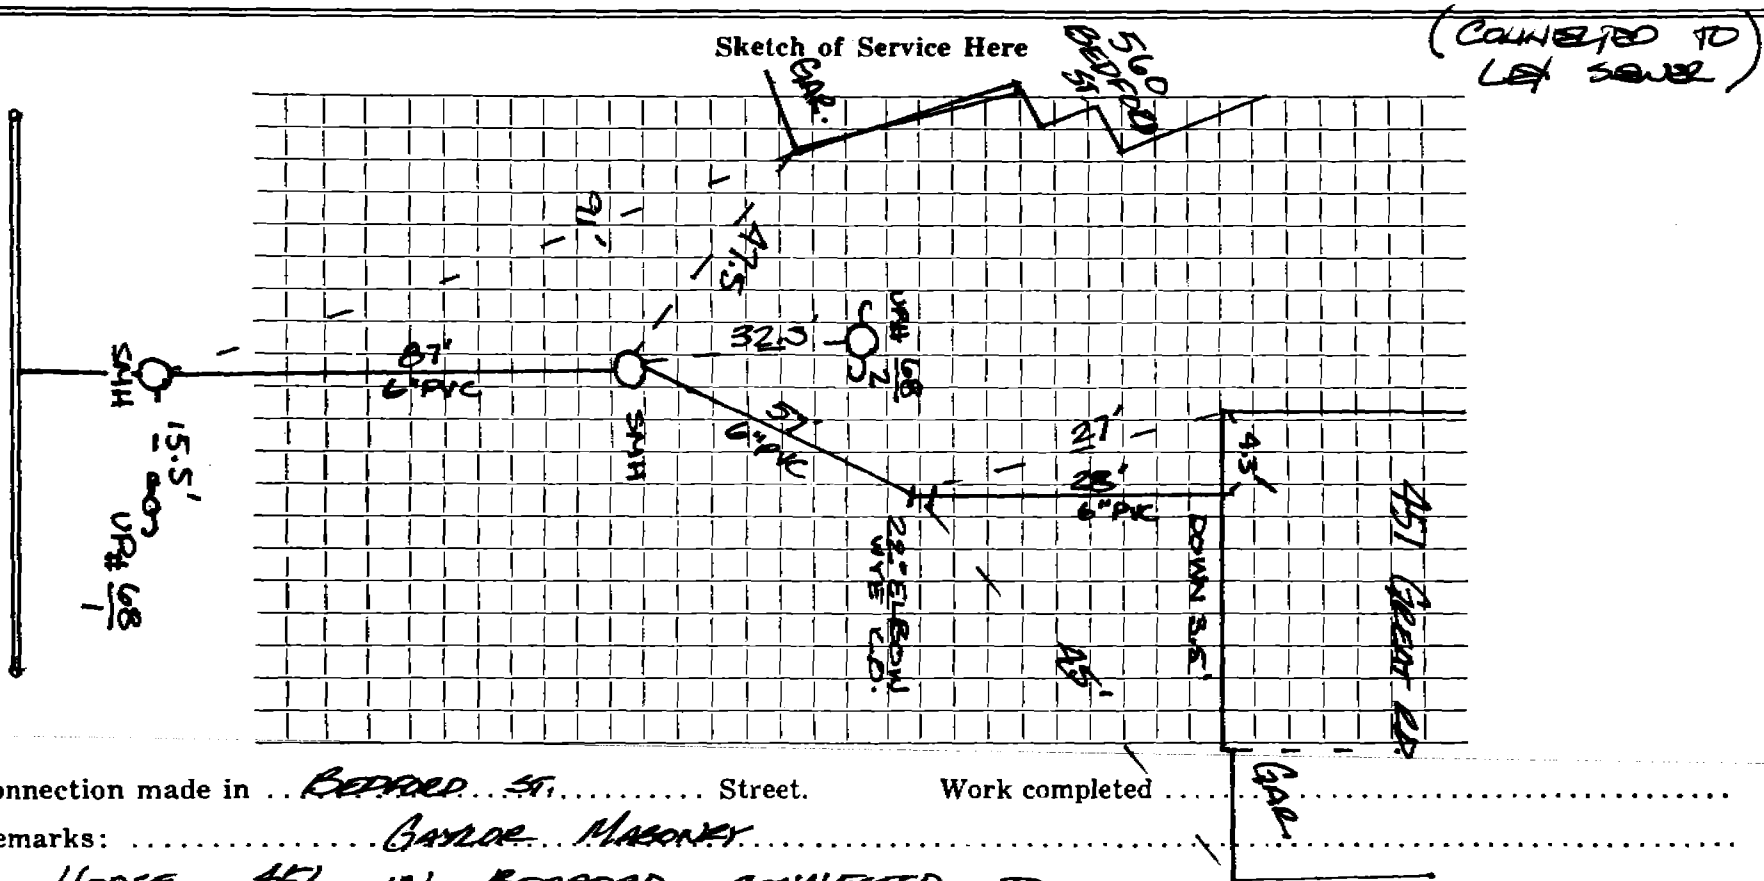

Connection made in .. BEDFORD ST. .. Street. Work completed ..

Remarks: .. GAYLOR MASONRY ..

.. HOUSE 451 IN BEDFORD CONNECTED TO ..
.. LEXINGTON SEWER ..