




DATE 4/13/88

TOWN OF LEXINGTON — BOARD OF PUBLIC WORKS  
SEWER DIVISION

Sketch of Service Here

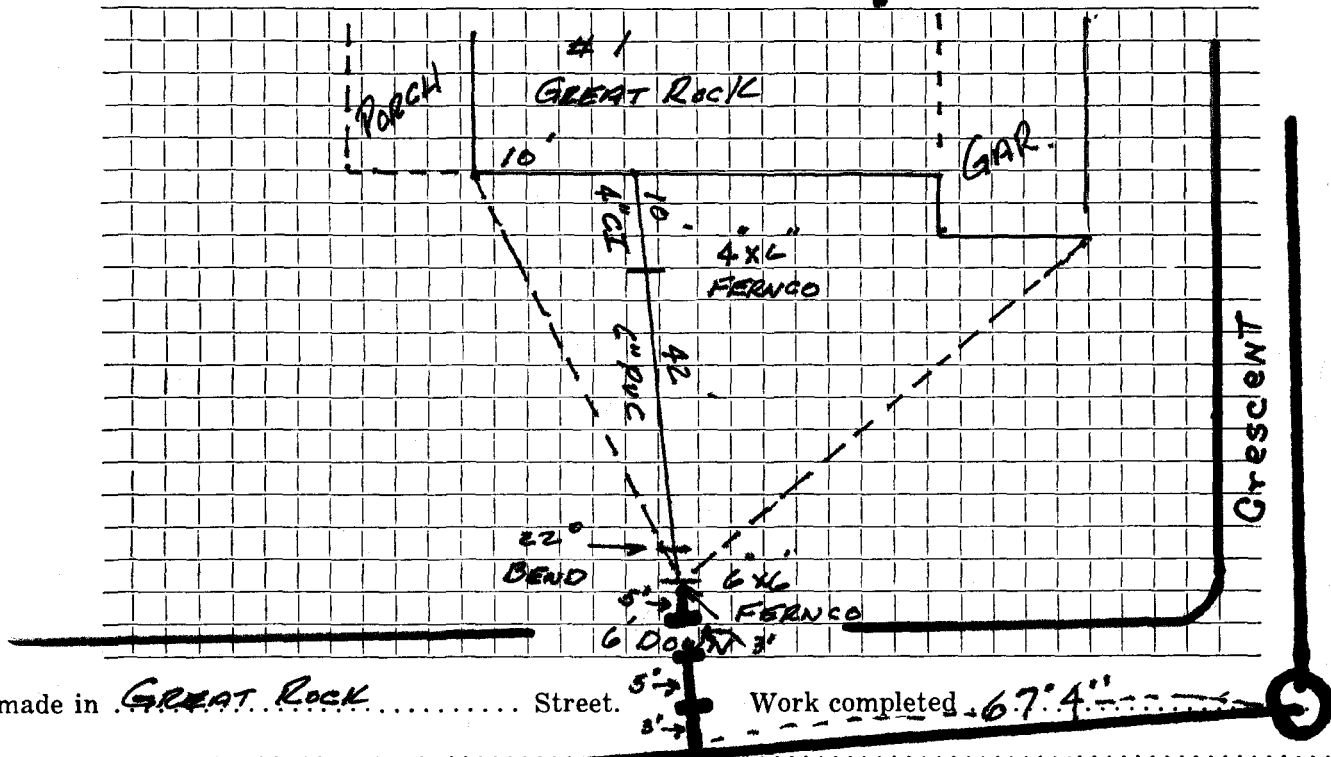

Name BROWN/EDITH NETTER

Service No. \_\_\_\_\_

Address # 2 GREAT ROCK

Location \_\_\_\_\_

Kind of Pipe AC

Size 6"

Size of Main 8"

Repair—Renewal— New Service

PERMIT NO. 0964-Suburbanite Cesspool


Location \_\_\_\_\_

Date	Material	Amount	Total	Date	Amount
8/18/78	25' 6" AC	\$14	\$330		

DATE MAY 23, 1997

TOWN OF LEXINGTON — BOARD OF PUBLIC WORKS  
**SEWER DIVISION**

Sketch of Service Here

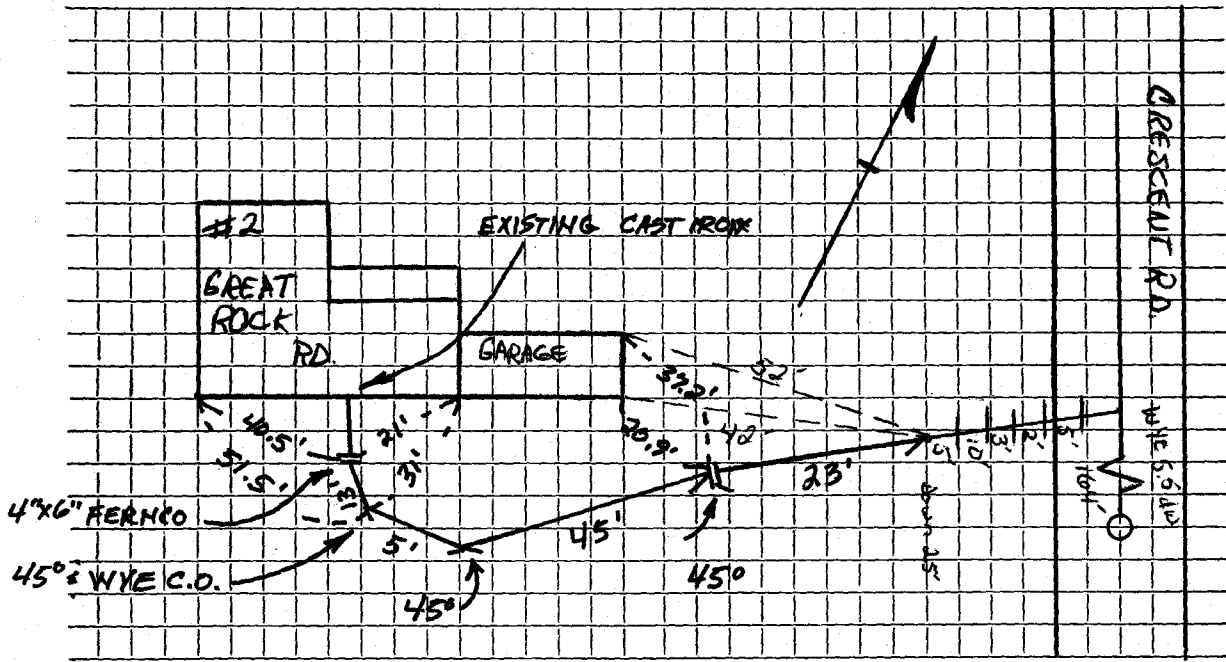

Connection made in CRESCENT ROAD Street. Work completed .....

Remarks: .....

Name Walter Pedrolì

Service No. 82

Address 4 Great Rock Rd.

Location

Kind of Pipe AC

Size 6"

Size of Main 8"

~~Repair~~ ~~Renewal~~ New Service Lexington Sewerage #3354


Location NOV 13 1978

Date	Material	Amount	Total	Date	Amount
<del>8/18/78</del>	<del>23' 6" Transite Pipe @14.00</del>		322.00	10-24-78	Deposit 322.00
11/20/78	62' 6" Transite pipe			8-18-78	
	5' 4" Cast Iron Pipe			23' 6" Transite	
				6-17-96	Roots 39'-51' out Homeowners problem

DATE \_\_\_\_\_

TOWN OF LEXINGTON — BOARD OF PUBLIC WORKS

SEWER DIVISION

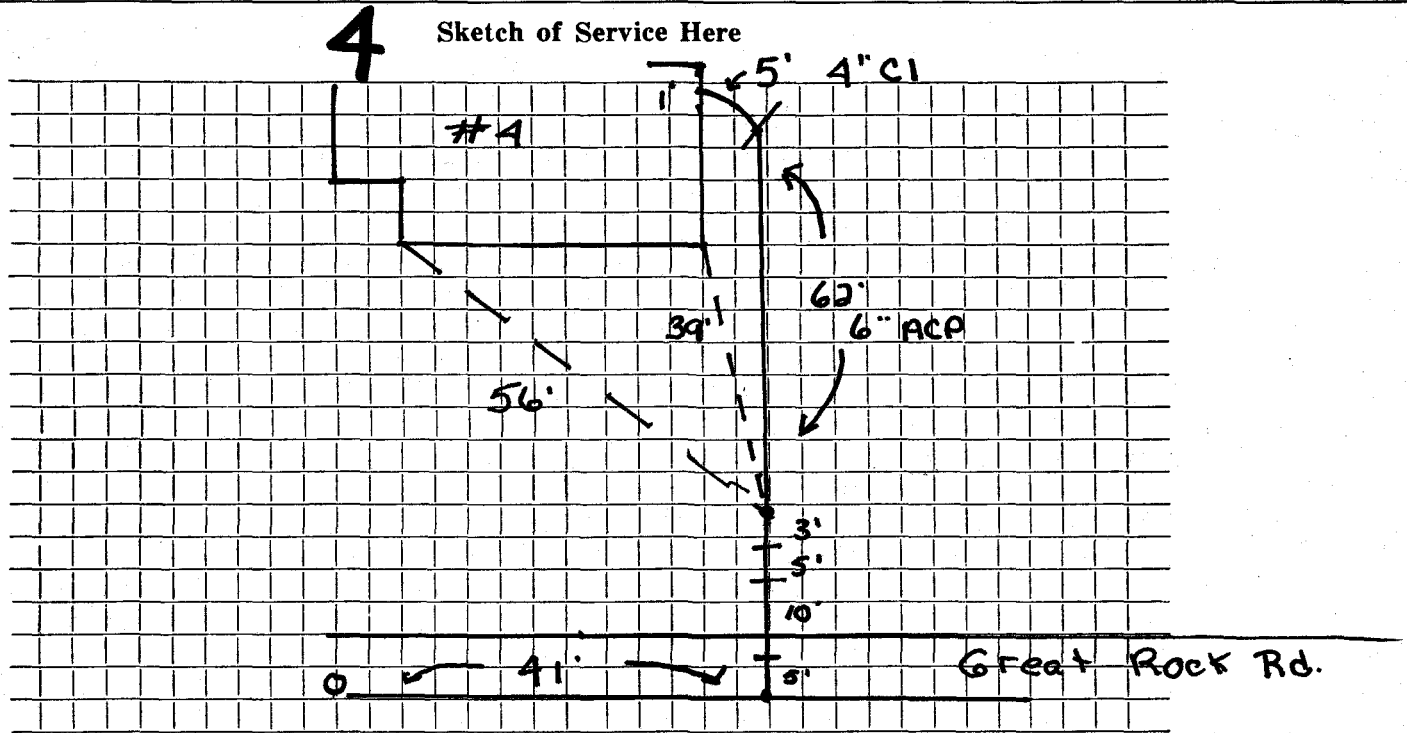

Connection made in ..... Street. Work completed .....

Remarks: .....

.....

.....