

Name Edwin Gittleman

Service No. 91

Address # 5 GREAT ROCK RD.

Location

Kind of Pipe AC

Size 6"

Size of Main 8"

Repaired Sewer ~~New Service~~ Lexington Sewerage #3203

Location DEC 20 1978

Date	Material	Amount	Total	Date	Amount
8/18/78	15' 6" AC	\$14	\$210	11-12-78	Deposit 210 ad
11/14/78	35' 6" Transite Pipe				
	5' 4" Cast Iron Pipe			8-18-78	15' 6" Transite


DATE \_\_\_\_\_

# TOWN OF LEXINGTON — BOARD OF PUBLIC WORKS

## SEWER DIVISION

Sketch of Service Here

5

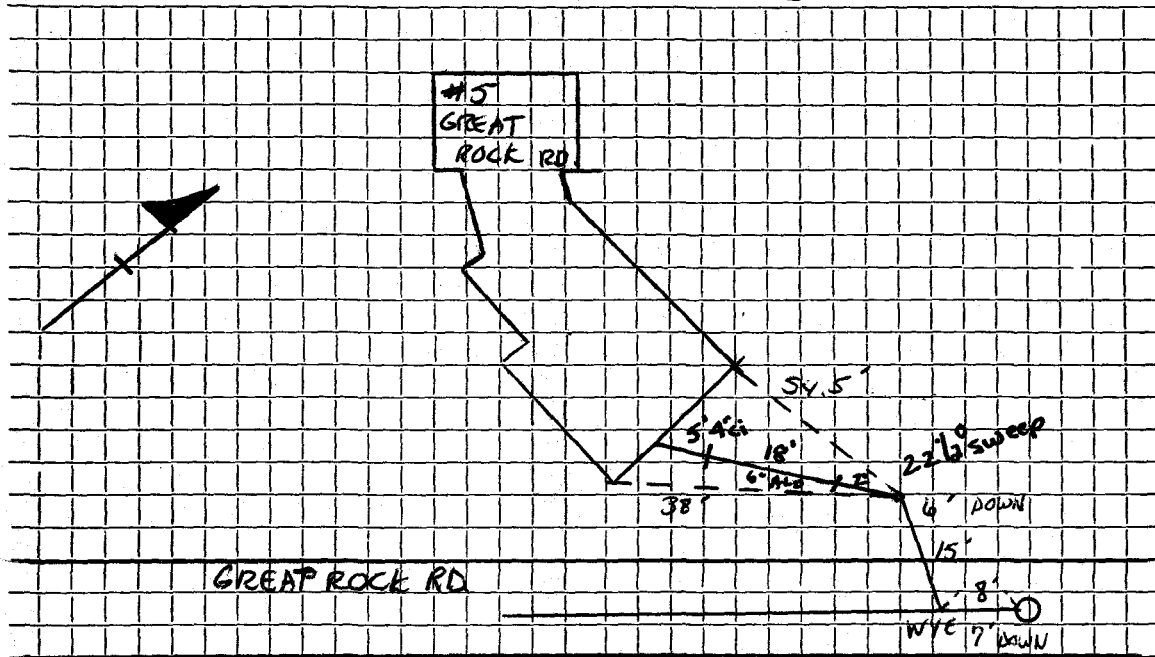

Connection made in ..... Street. Work completed .....

Remarks: .....

.....

.....