

Name

Service No.

Address # 6 GREAT ROCK RD.

Location

Kind of Pipe AC

Size 6"

Size of Main 8"

Repair—Renewal—New Service ✓


Location

Date	Material	Amount	Total	Date	Amount
8/13/78	28' 6" AC	\$14	\$392		
				8-18-78	
				33' 6" TRANSITE	

DATE _____

TOWN OF LEXINGTON — BOARD OF PUBLIC WORKS
SEWER DIVISION

Sketch of Service Here **6**

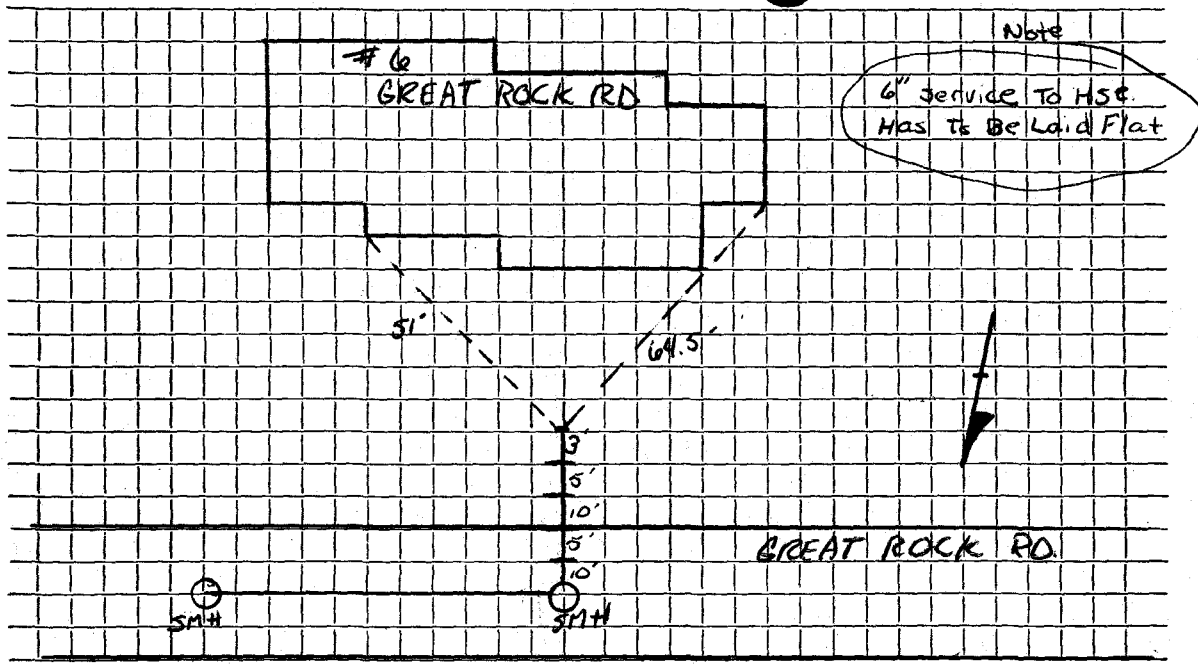

Connection made in Street. Work completed

Remarks:
.....
.....