

Name Beverly Phelan

Service No. 51

Address # 7 GREAT Rock RD.

Location

Kind of Pipe AC

Size 6"

Size of Main 8"

Repair—Renewal—New Service Bruce McKee #4639

Location

| Date | Material | Amount | Total | Date | Amount |
|--------------------|----------------------|-----------------|------------------|--------------------|-------------------|
| 8/18/78 | 20' 6" AC | \$14 | \$280 | 3-23-88 | 339.00 |
| | 1 CY LOAM | \$9 | \$9 | | |
| | 10' PATCH | \$5 | \$50 | 8-18-78 | |
| | | | 339. / | 20' 6" Transite | |
| 3/23/88 | 71' 6" PVC | | | | |
| | 2 22° Bends | | | | |
| | 1 AC to PVC Fernco | | | | |
| | 1 4 x 6" Fernco | | | | |


DATE _____

TOWN OF LEXINGTON — BOARD OF PUBLIC WORKS

SEWER DIVISION

Sketch of Service Here

7

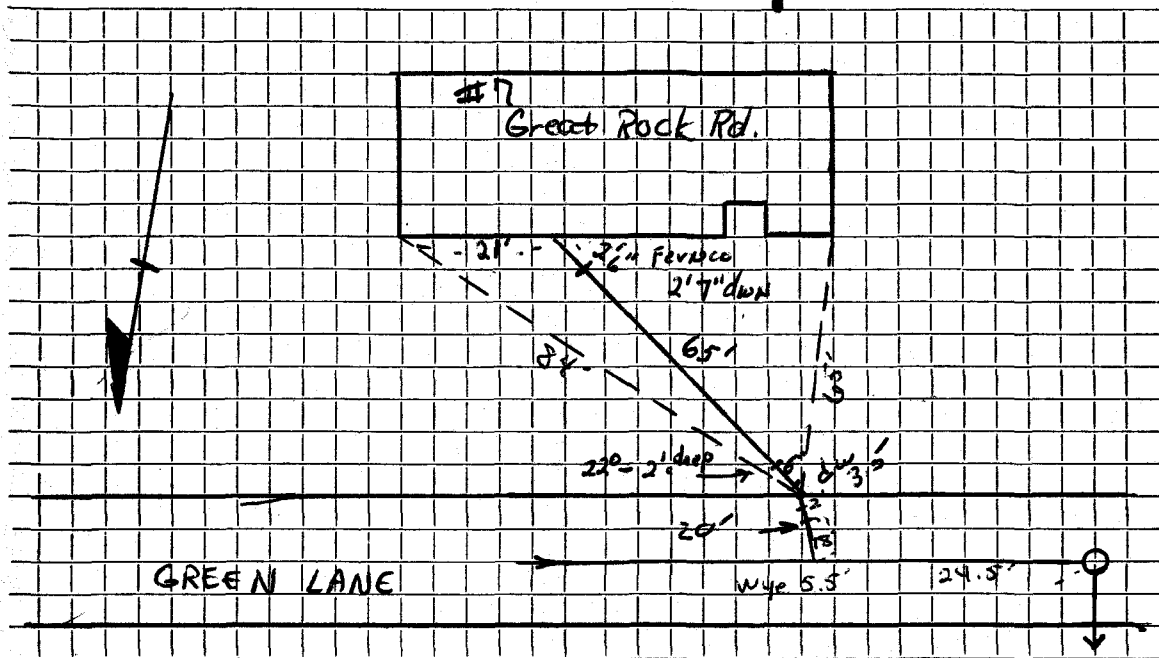

Connection made in Street. Work completed

Remarks:

.....

.....