


DATE FEB 26, 2002

TOWN OF LEXINGTON — BOARD OF PUBLIC WORKS
SEWER DIVISION

Sketch of Service Here

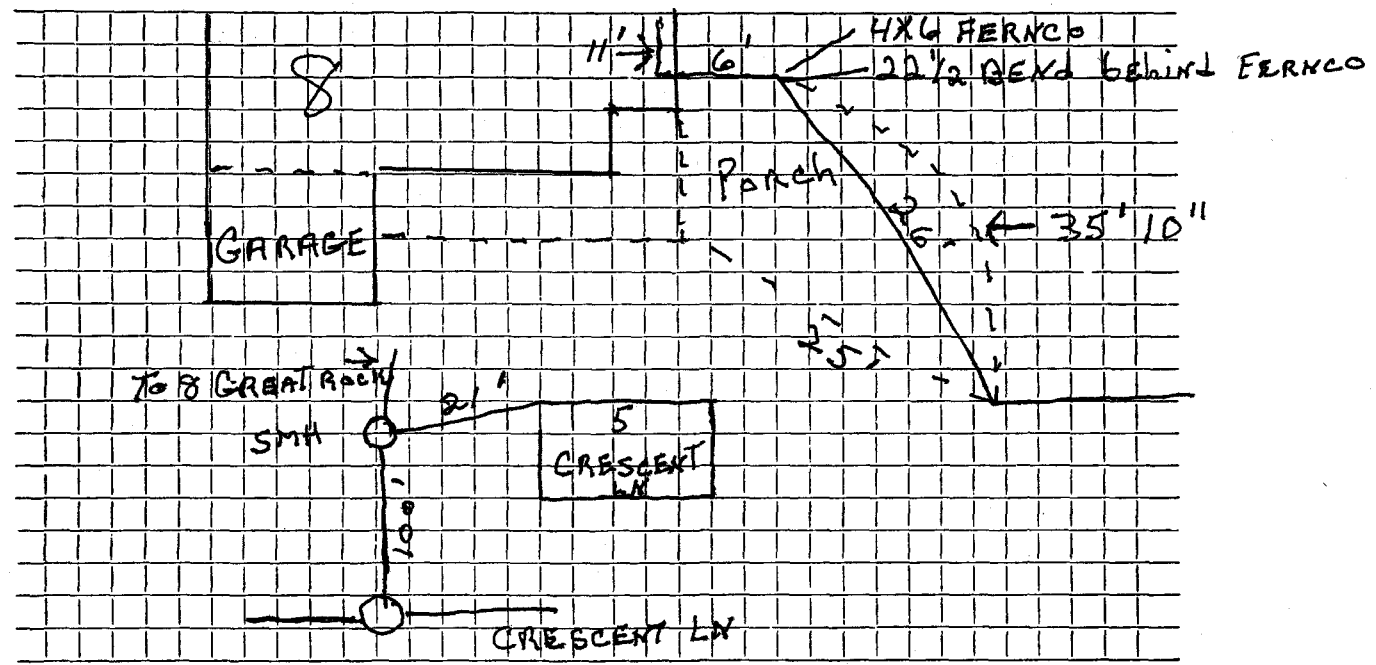

Connection made in GREAT... ROCK... Rd. Street. Work completed

Remarks: INSTALLED... BY... J.M. McLAUGHLIN

SERVICE RUNS OUT TO MANHOLE ON CRESCENT LN