

Name Gerald Bogosian

Service No. 63

Address 10 Green Lane

Location

Kind of Pipe

Size

Size of Main

Repair—Renewal—New Service

WO# 8005

Location

Comm 10-28-65


Date	Material	Amount	Total	Date	Amount
6-14-63	Labor	141 88		6-6-63	450 00
6-17-63	"	72 57		11-22-63	43 34
	10% O.H.	21 45	235 90		493 34
	130' 6" Transite Pipe @ .82		106 60		
	40½ ton ¾" Stone @ 1.50		60 75		
	1 90° Transite Elbow		4 09		
	10 yds. Loam @ 3.00		30 00		
	4 hrs. Town Shovel @ 6.50		26 00		
	8 hrs. Trucking @ 3.00		24 00		
	2 hrs. Pumping @ 3.00		6 00		
			<u>493 34</u>		
				4-8-67	ROOTS
					Bill sent 43.34

DATE _____

TOWN OF LEXINGTON — BOARD OF PUBLIC WORKS

SEWER DIVISION

Sketch of Service Here **10**
GREEN LANE

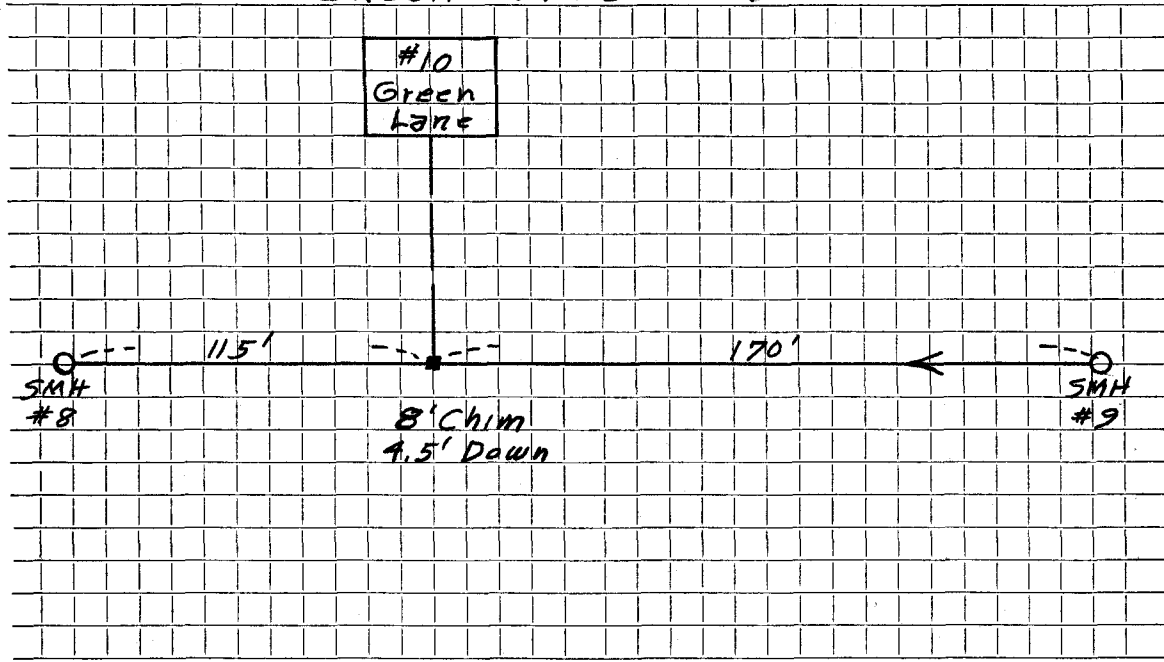

Connection made in Street. Work completed

Remarks:
.....
.....