

Name Anthony Mazza

Service No. 42

Address 12 Green Lane

Location

Kind of Pipe

Size

Size of Main

~~Renewal~~ New Service 110 # 7928

Location Comm 8-26-63

Date	Material	Amount	Total	Date	Amount
6-11-63	Labor	55.80		5-14-63	450.00
6-12-63	"	120.91	176.71	8-26-63	56.00
	10% O.H.	17.67	194.38		394.00
	110' 6" Transite pipe @.88		96.80		
	7 1/4 ton 3/4" Stone @1.50		10.88		
	1 90° Transite Elbow		4.09		
	1 11 1/4° Transite Elbow		2.35		
	5 hrs. Town Shovel @6.50		32.50		
	6 hrs. Trucking @3.00		18.00		
	1 hr. Trailer @3.00		3.00		
	2 hrs. Pumping @1.00		2.00		
	10 yds. Loam @3.00		30.00		
			394.00		

DATE \_\_\_\_\_


TOWN OF LEXINGTON — BOARD OF PUBLIC WORKS

SEWER DIVISION

Sketch of Service Here

12

GREEN LANE

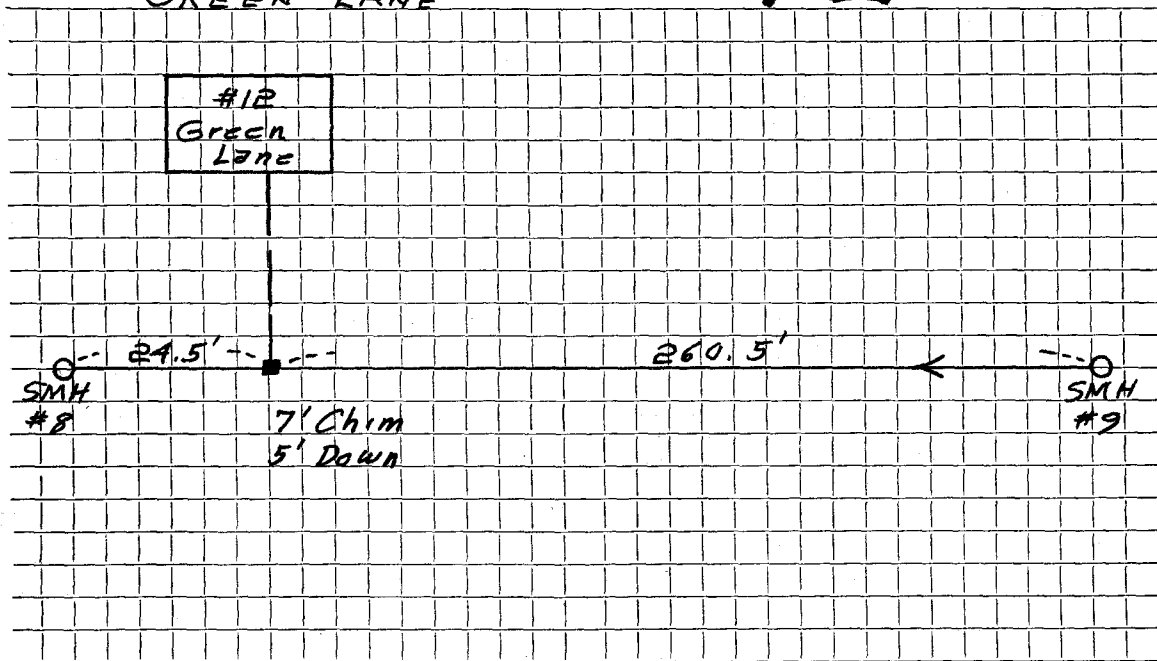

Connection made in ..... Street. Work completed .....

Remarks: .....  
.....  
.....