

Name Anthony DiPietro

Service No.

Address 14 Green Lane

Location

Kind of Pipe

Size

Size of Main

Repair—Renewal—New Service

Trebino # 2156

Location

| Date | | Material | Amount | Total | Date | Amount |
|--------|------|--------------|--------|-------|------|--------|
| 7-8-72 | 110' | 5" Transite | | | | |
| | 10' | 4" Cast Iron | | | | |
| | | | | | | |
| | | | | | | |

DATE _____

TOWN OF LEXINGTON — BOARD OF PUBLIC WORKS

SEWER DIVISION

14 Sketch of Service Here

Green Lane

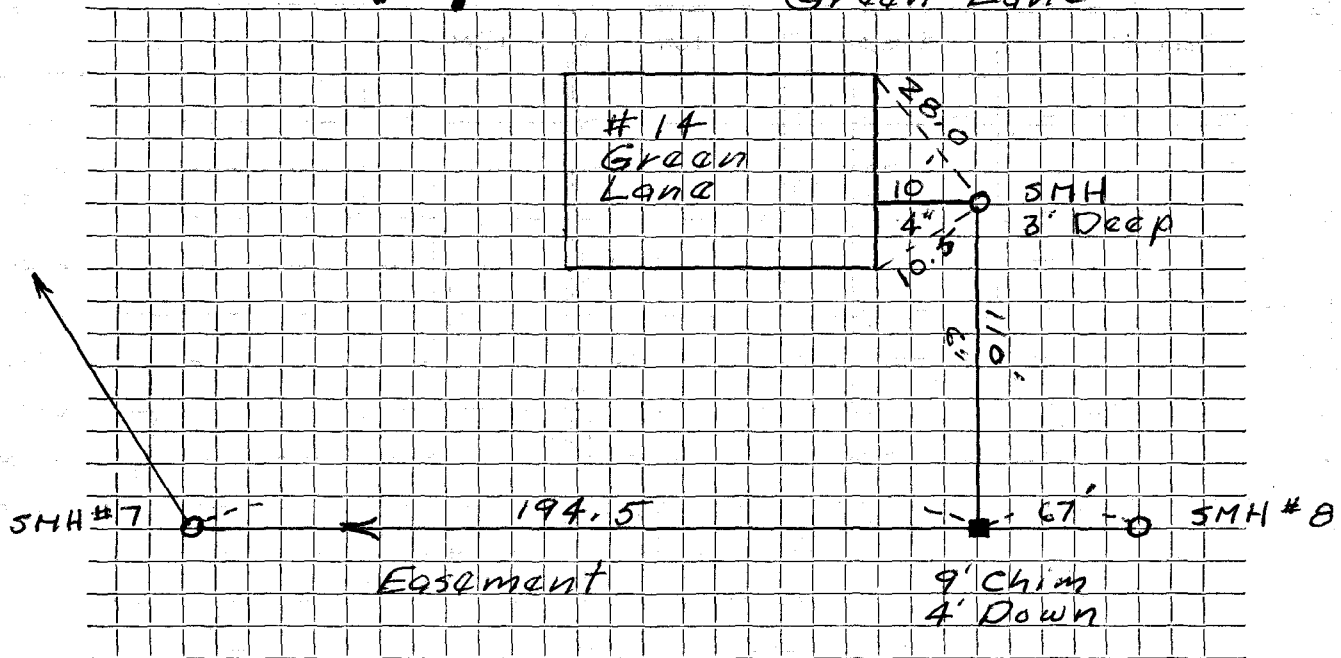

Connection made in Easement Street. Work completed

Remarks:
.....
.....