

Name William Antonucci

Service No. 89

Address 16 Green Lane

Location

Kind of Pipe

Size

Size of Main

~~Repair~~ ~~Renewal~~ — New Service W 0 # 73 72

Location Comm 10-1-62

Date	Material	Amount	Total	Date	Amount
6-25-62	Labor	113.79		6-20-62	500 00
6-26-62	"	125.98		5-17-63	194 00
6-27-62	"	86.22			694 00
6-30-62	"	72.31	398.30		
	10% O.H.		39.83		
	143' Transite pipe @.78		111.54		
	31 3/4 ton 1" Stone @1.65 ton		52.39		
	1 90° Transite Elbow		4.09		
	1 11 1/4" Transite Elbow		2.35		
	5 hrs. Town Shovel @6.50		32.50		
	7 hrs. Trucking @3.00		21.00		
	16 hrs. Pumping @1.00		16.00		
	4 hrs. 4 in one Shovel @4.00		16.00		
			694.00		


DATE _____

TOWN OF LEXINGTON — BOARD OF PUBLIC WORKS

SEWER DIVISION

Sketch of Service Here

16

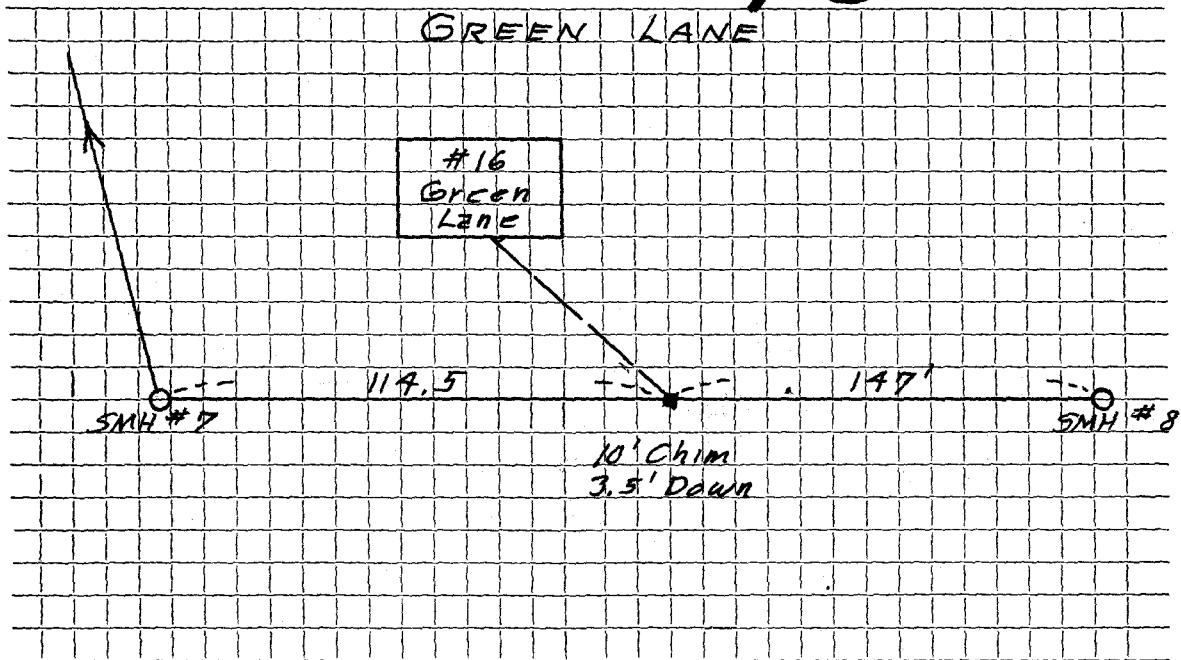

Connection made in Street. Work completed

Remarks:
.....
.....