


DATE _____

TOWN OF LEXINGTON — BOARD OF PUBLIC WORKS
SEWER DIVISION

Sketch of Service Here **17**

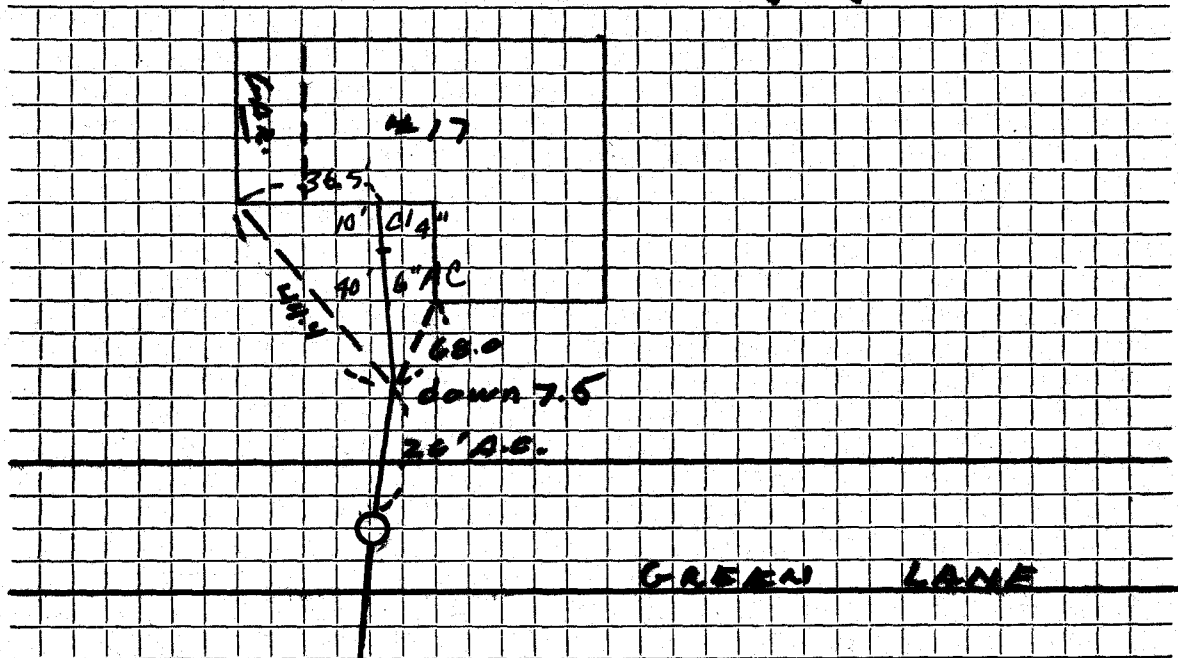

Connection made in .. GREEN LANE .. Street. Work completed .. JULY 25, 1975 ..

Remarks: ..
.....
.....