

Name Antonio B. Nardelli

Service No. 27

Address 6 Green Lane

Location

Kind of Pipe

Size

Size of Main

~~Repair/General~~ — New Service Suburbanite #3990

Location OCT 21 1985

Date		Material	Amount	Total	Date	Amount
8/18/78	6'	6" A.C. pipe @ \$14.00		\$84.00	8-6-85	84 00
8/19/85	18½'	6" P.V.C.			<i>Deposit</i>	
	8'	4" Cast				
	1	4" Tee Wye Cleanout				
	1	4" 22° Bend				
	1	4" x 6" Donut				
	1	PVC to AC Fernco				
	1	6" 22° Bend				


DATE \_\_\_\_\_

# TOWN OF LEXINGTON — BOARD OF PUBLIC WORKS

## SEWER DIVISION

Sketch of Service Here

# 6

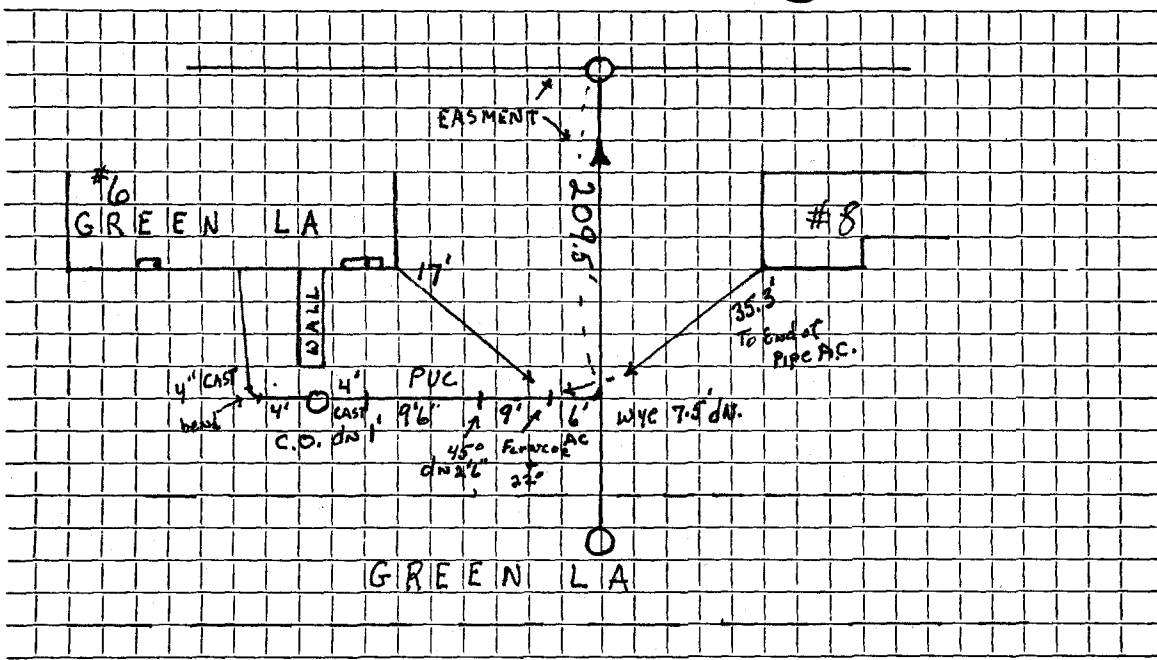

Connection made in ..... Street. Work completed .....

Remarks: .....

.....

.....