




DATE 10/23/92

TOWN OF LEYINGTON - BOARD OF PUBLIC WORKS  
SEWER DIVISION

Sketch of Service Here

7

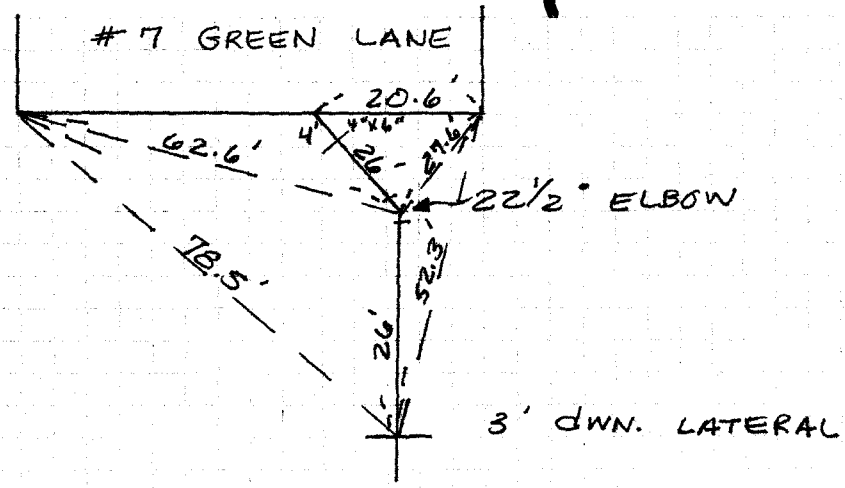

GREEN

LANE

BRUCE MCKEE