

Name Bernard Maloney

Service No. 37

Address 1 Greenwood Street

12/17/60 - MARBELL - PCR Frank Leahy  
Engineer

Kind of Pipe

Size

Size of Main

~~REPAIR EXISTING~~ - New Service

Location Camm 5-9-60


Date	Material	Amount	Total	Date	Amount
4-25-60	Labor	85.38		4-13-60	Deposit 200.00
	10% O.H.	8.54	93.92	5-9-60	Paid by WNC#34 23.71
	60' 6" Transite pipe @.78		46.80	7-16-60	Paid 15.49
	1 6" Transite Elbow 90°		5.29		NON CHARGE 239.20
	1 11 1/4° Transite Elbow		2.24		Labor 15.90
	1 22 1/2° Transite Elbow		2.24		(waiting for eng.'S)
	1 22 1/2° Transite Bend		6.21		
	3 hrs. Town Shovel @6.50		19.50		
	2 hrs. Trucking @3.00		6.00		
	1 hr. Rogers Trailer @3.00		3.00		
	27 x 6 Patch		54.00		
			239.20		

Bill sent 5-9-60 15.49

DATE \_\_\_\_\_

**TOWN OF LEXINGTON — BOARD OF PUBLIC WORKS**  
**SEWER DIVISION**

Sketch of Service Here

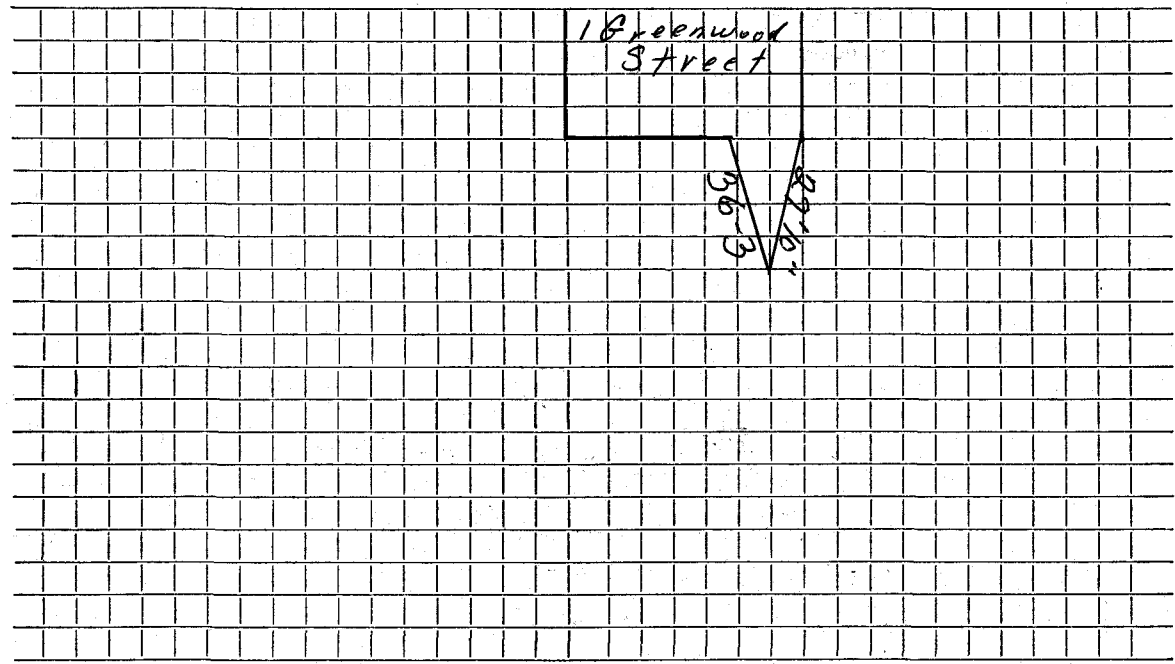

Connection made in ..... Street. Work completed .....

Remarks: .....  
.....  
.....

80.00

~~GREENWOOD ST.~~

MR BERNARD MALONEY

$$18.42 \times 80' = 1473.60 \div 2 = 736.80$$

$$736.80 \div 16,000^{\square} = \text{Rate } .04605$$

$$8000^{\square} \times .04605 = \text{\$}368.40$$

HARBELL

LIMIT

OF ASSESSMENT



100

8000'

TO BE ASSESSED  
FOR SEWER

S.T.