

Name Robert C. Cady

Service No. 196

Address 10 Greenwood St.

Location

Kind of Pipe

Size

Size of Main

~~Repair/Replacement~~ New ServiceLocation *Comp 11-21-60*


Date	Material	Amount	Total	Date	Amount
	20' 6" Transite pipe @3.50			<i>10-3-60</i>	<i>Deposit 200 00</i>
	installed by cont.		70 00	<i>11-21-60</i>	<i>Paid by WHPA 211 6 06</i>
10-7-60	Labor	62 99			
10-10-60	"	23 10			
	10% O.H.	8 61	94 70		
	67' 6" Transite pipe @78		52 26		
	1 Cesspool Cover & Frame		10 50		
	100 Bricks Sewer		4 20		
	2 Bags Cement @1.50		3 00		
	1 Ton Sand		1 00		
	4 Hrs. Pippin Shovel @4.50		18 00		
	2 Hr. Trucking @3.00		6 00		
			189 66		
				<i>Ball seat 11-21-60 33.60</i>	

DATE _____

TOWN OF LEXINGTON — BOARD OF PUBLIC WORKS

SEWER DIVISION

Sketch of Service Here

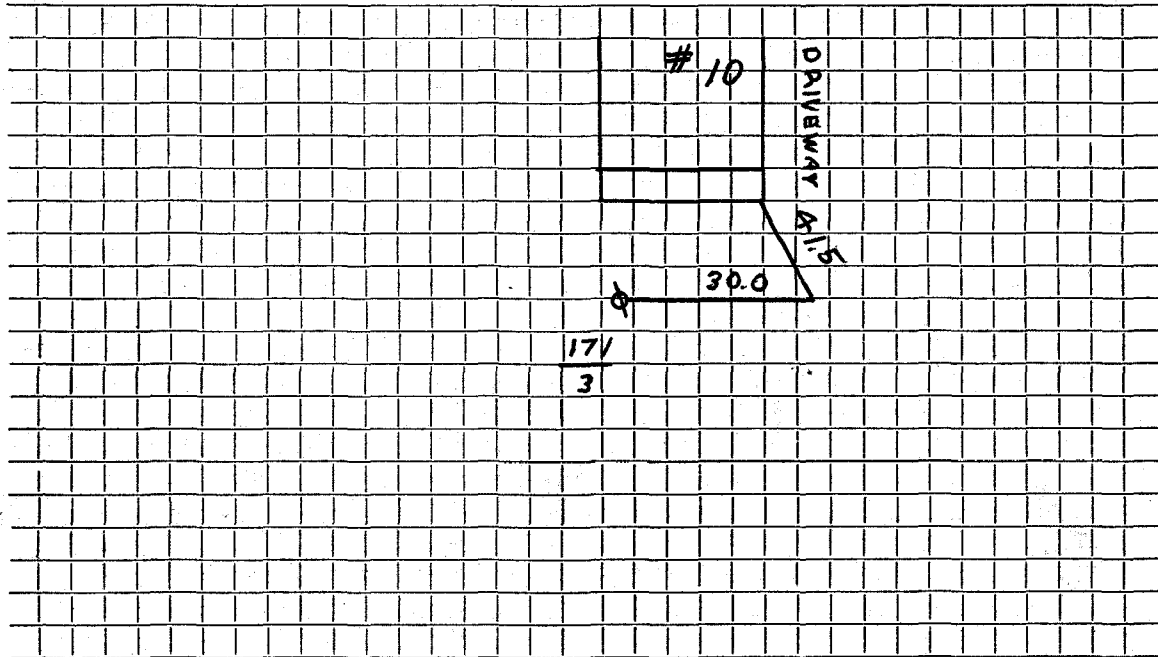

Connection made in Greenwood Street. Work completed

Remarks:
.....
.....