

Name

Service No.

Address

14 Greenwood St.

Lot " 359-362

Location

Kind of Pipe

Size

Size of Main

Repair—Renewal—New Service

Location

Date

Material

Amount

Total

Date

Amount

~~15' 6" Transite pipe @3.50~~

installed by cont.


52 50

15' 6" Transite

DATE _____

TOWN OF LEXINGTON — BOARD OF PUBLIC WORKS
SEWER DIVISION

Sketch of Service Here

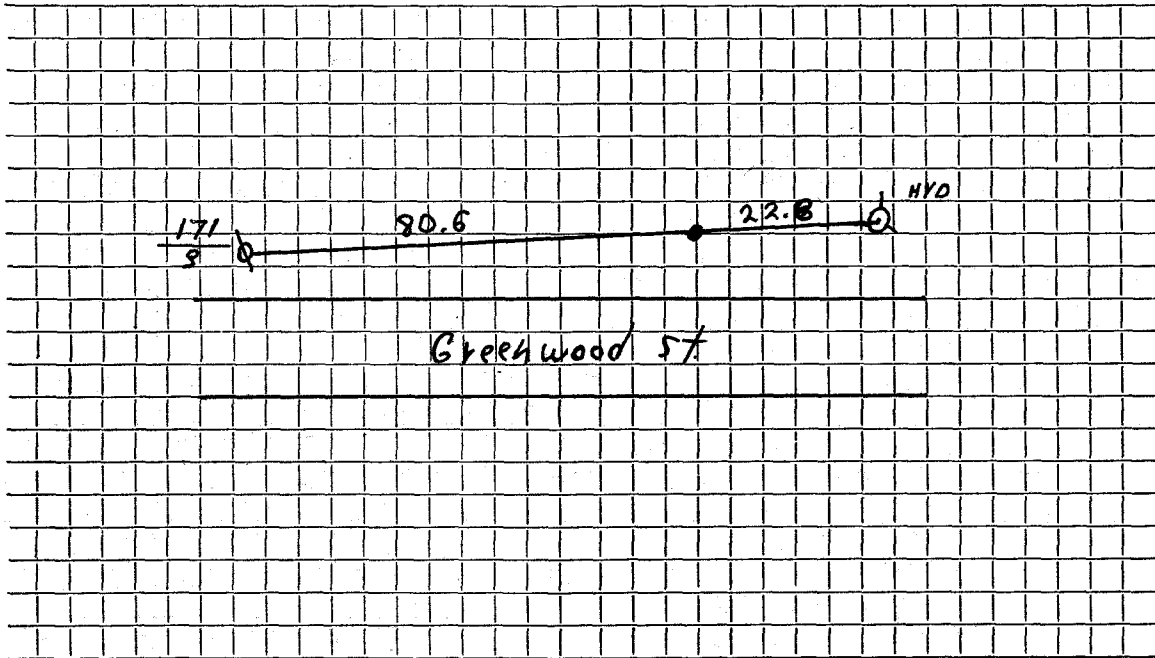

Connection made in Greenwood St Street. Work completed

Remarks:
.....
.....