




DATE \_\_\_\_\_

# TOWN OF LEXINGTON — BOARD OF PUBLIC WORKS

## SEWER DIVISION

Sketch of Service Here  
S.M.H. 6" Lot 389

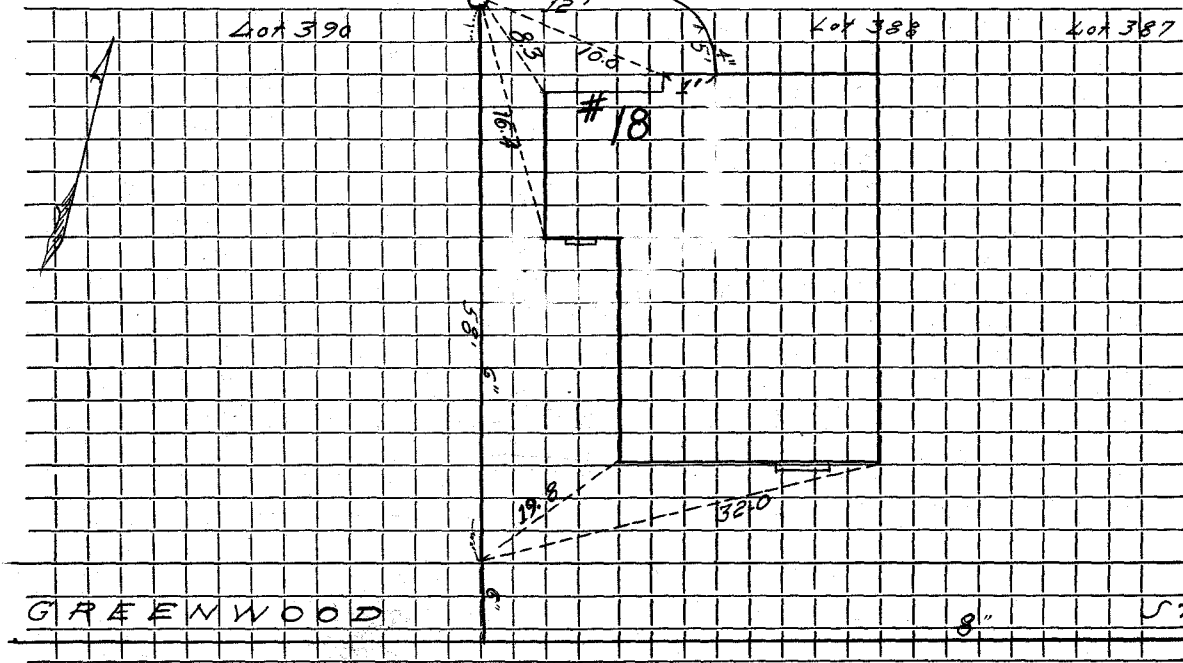

ASBURY ST.

Connection made in Greenwood Street. Work completed .....

Remarks: .....