


DATE JUNE 17 1998

TOWN OF LEXINGTON — BOARD OF PUBLIC WORKS
SEWER DIVISION

Sketch of Service Here

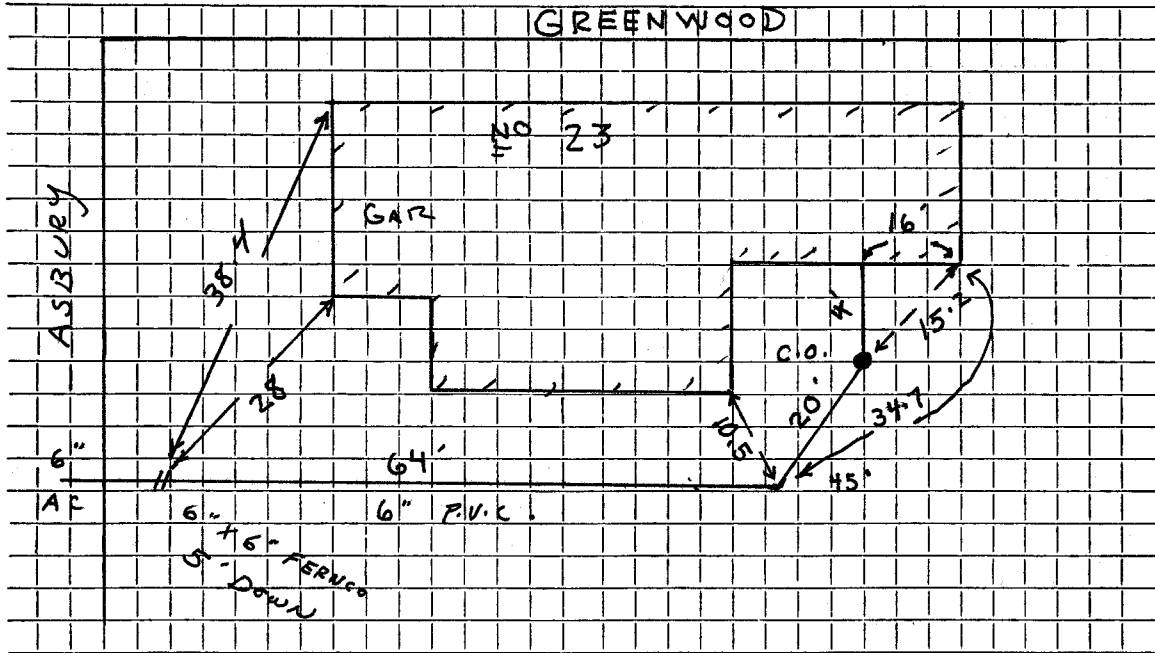

Connection made in ASBURY Street. Work completed SUBURBANITE CESSPOOL

Remarks:

..... FIELD BOOK 98-2


..... T.S.M.

DATE _____

TOWN OF LEXINGTON — BOARD OF PUBLIC WORKS

SEWER DIVISION

Sketch of Service Here

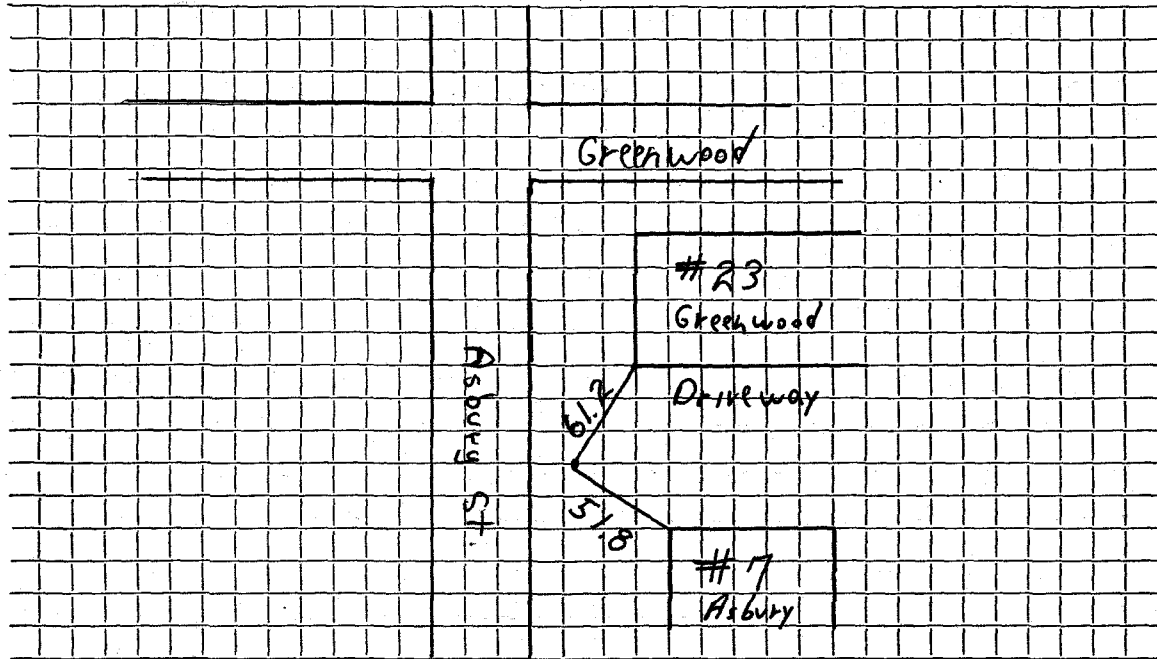

Connection made in Asbury Street. Work completed

Remarks:
.....
.....