

Name Dianne Estates, Inc.

Service No. 261

Address 26 Greenwood St.

Location

Kind of Pipe

Size

Size of Main

~~Revised~~ New Service


Location *Comm 12-31-60*

Date	Material	Amount	Total	Date	Amount
	15' 6" Transite pipe @ 3.50			11-22-60	
	installed by cont.		52 50	12-31-60	
					53 00
					50
					52 50
					15' 6" Transite

DATE _____

TOWN OF LEXINGTON — BOARD OF PUBLIC WORKS
SEWER DIVISION

Sketch of Service Here

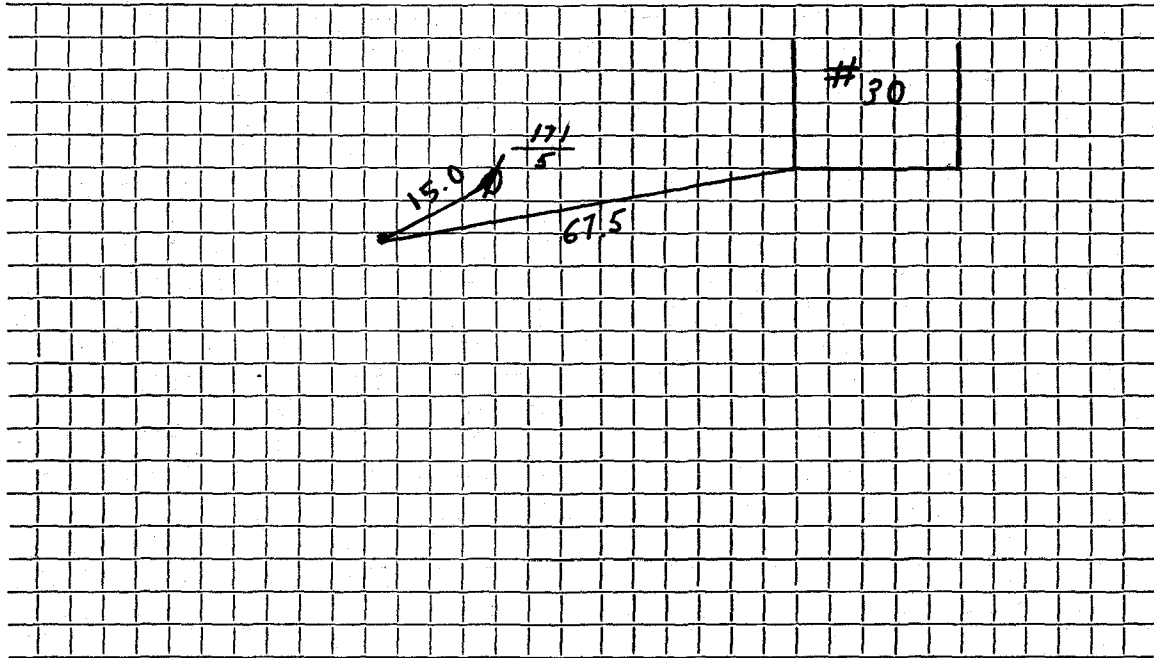

Connection made in Greenwood Street. Work completed

Remarks:
.....
.....