

Name Richard E. Willey

Service No. 49

Address 29 Greenwood Street

Location

Kind of Pipe

Size

Size of Main

~~Repair~~ ~~Renewal~~ - New Service


Location Comm 6-1-59

Date	Material	Amount	Total	Date		Amount
5-8-59	Labor	19.60		4-30-59	Deposit	200.00
5-9-59	Labor	65.50	85.10	6-1-59	Refund	36.44
	10% O.H.	<del>XXXX</del>	8.51			<u>163.56</u>
	40' 6" Transite Pipe @.70		28.00		NON CHARGE	
	1 22 $\frac{1}{2}$ " Transite Bend		6.21	5-9-59	Labor	32.50
	1 11 $\frac{1}{4}$ " Transite Elbow		2.24			
	4 hrs. Town Shovel @6.50		26.00			
	2 hrs. Trucking @.75		1.50			
	1 hr. Trucking @3.00		3.00			
	1 hr. Rodgers Trailer @3.00		3.00			
			<u>163.56</u>			

DATE \_\_\_\_\_

TOWN OF LEXINGTON — BOARD OF PUBLIC WORKS  
SEWER DIVISION

Sketch of Service Here

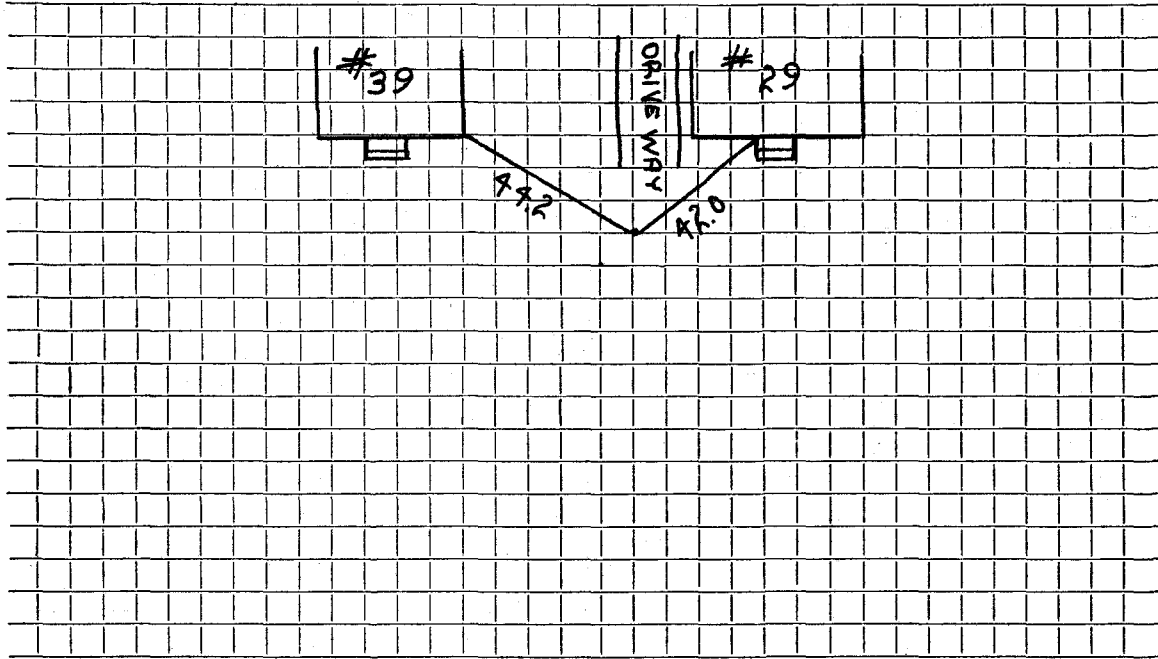

Connection made in ..... Street.      Work completed .....

Remarks: .....  
.....  
.....