


DATE _____

TOWN OF LEXINGTON — BOARD OF PUBLIC WORKS

SEWER DIVISION

30

Sketch of Service Here

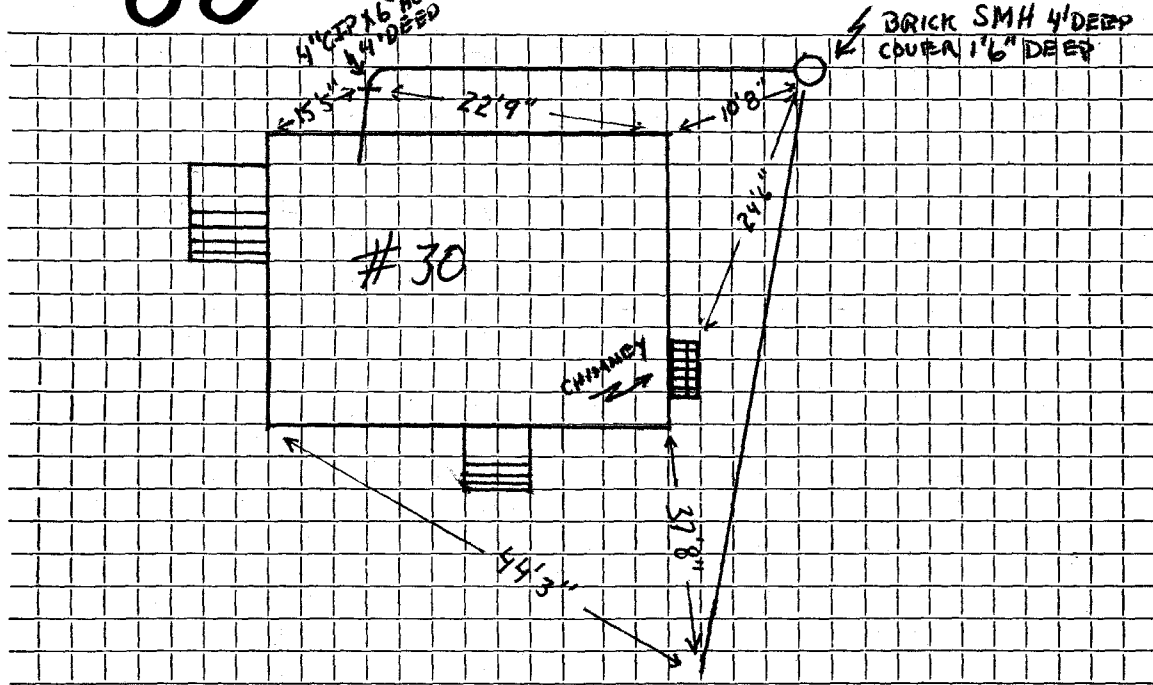

Connection made in GREENWOOD Street. Work completed

Remarks:
.....
.....