




DATE \_\_\_\_\_

TOWN OF LEXINGTON — BOARD OF PUBLIC WORKS  
SEWER DIVISION

Sketch of Service Here

32

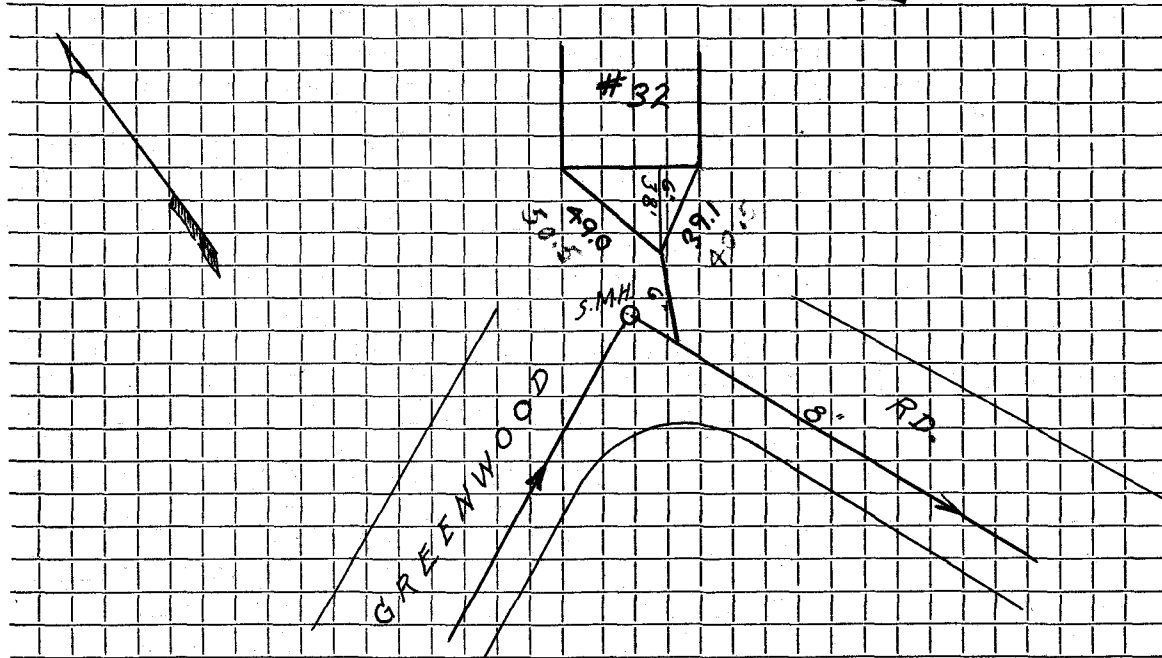

Connection made in Greenwood Street. Work completed .....

Remarks: .....