

Name Orville Scribner

Service No. 132

Address 34 Greenwood St

Location

Kind of Pipe

Size

Size of Main

~~XXXXXX~~ New ServiceLocation *Comm* 9-19-60

Date

Material

Amount

Total

Date

Amount

~~25' 6" Transite pipe @3.50~~

7-19-60

Deposit

125.00

installed by cont.

87.50

2-13-61

Paid

83.47

7-26-60

Labor

98.59

258.47

10% O.H.

9.86

108.45

25' 6" Transite

39' 6" Transite pipe @.78

30.42

1 1 1/4" Transite Bend

5.10

3 hrs. Trucking @3.00

9.00

4 hrs. Pippin Shovel @4.50

18.00

258.47

Bill sent 9-19-60 83.47


DATE \_\_\_\_\_

TOWN OF LEXINGTON — BOARD OF PUBLIC WORKS

SEWER DIVISION

Sketch of Service Here

34

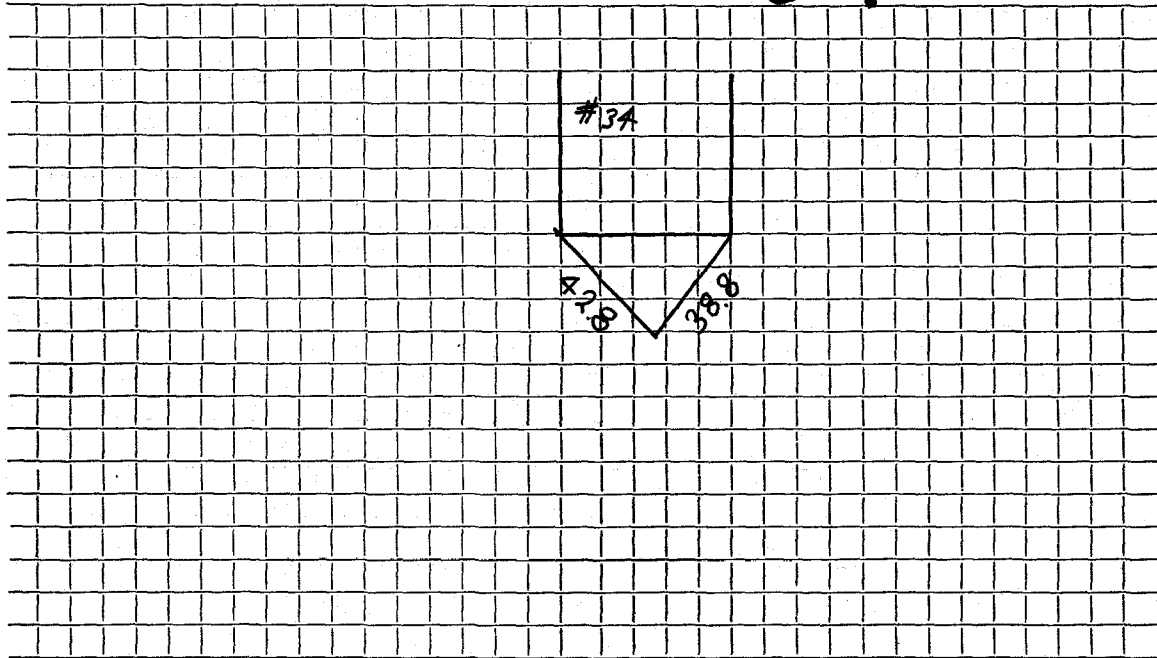

Connection made in Greenwood Street. Work completed .....

Remarks: .....  
.....  
.....