

Name **Louis F. Hallowell**

Service No. **50**

Address **38 Greenwood St.**

Location

Kind of Pipe

Size

Size of Main

~~Repair - Renewal~~ **New Service**

Location *Conn 7-5-60*


Date	Material	Amount	Total	Date	Amount
	25' 6" Transite pipe @3.50			<i>4-25-61</i>	<i>Deposit 175 00</i>
	<i>installed by cont.</i>		<i>87 50</i>	<i>2-8-41</i>	<i>Paid 24 92</i>
<i>5-5-60</i>	<i>Labor</i>	<i>54 11</i>			<i>199 92</i>
	<i>10% O.H.</i>	<i>5 41</i>	<i>59 52</i>		
	<i>30' 6" Transite pipe @78</i>		<i>23 80</i>		
	<i>1 11 1/4° Bend</i>		<i>5 10</i>		
	<i>4 Hrs Pippin Shovel @4.50</i>		<i>18 00</i>		
	<i>2 Hrs Trucking @3.00</i>		<i>6 00</i>		
			<i>199 92</i>		
				<i>5/3/73</i>	<i>Solids</i>
				<i>12-30-73</i>	<i>Roots</i>
				<i>Bill 5-20-60</i>	<i>2-192</i>

DATE _____

TOWN OF LEXINGTON — BOARD OF PUBLIC WORKS
SEWER DIVISION

Sketch of Service Here

38

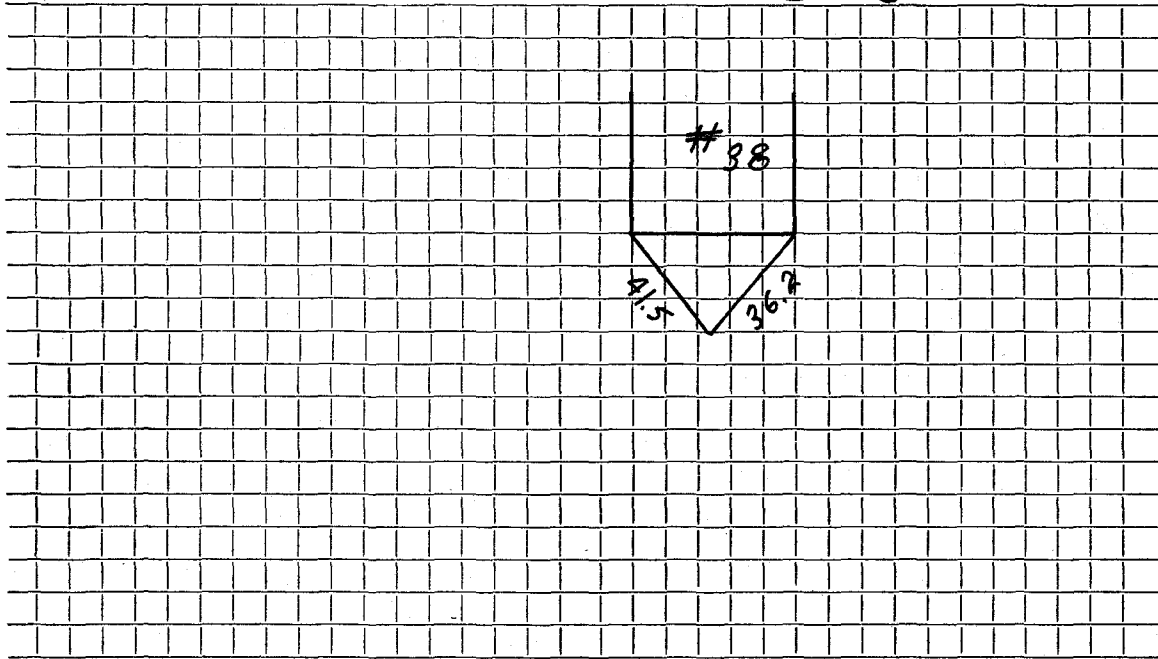

Connection made in Greenwood Street. Work completed

Remarks:
.....
.....