




DATE \_\_\_\_\_

TOWN OF LEXINGTON — BOARD OF PUBLIC WORKS  
SEWER DIVISION

Sketch of Service Here

42

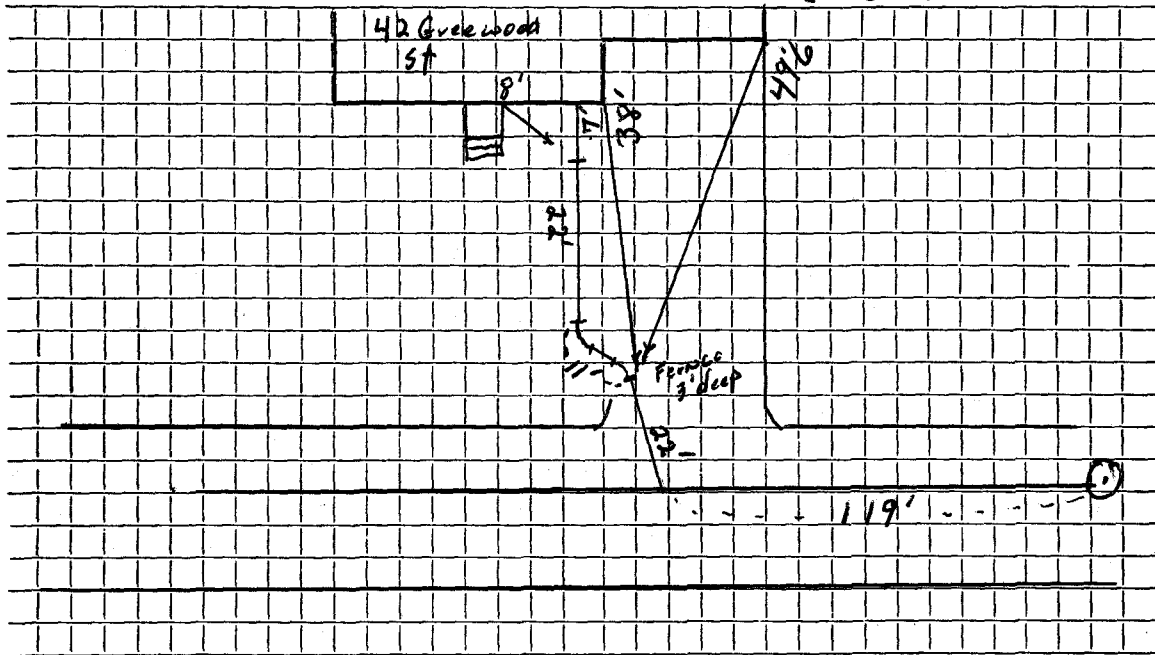

Connection made in ..... Street. Work completed .....

Remarks: CUT AC BACK 3' WAS 25' .....