

Name

Kathleen Rockstroh

Service No. 21

Address

44 Greenwood St.

Location

Kind of Pipe

Size

Size of Main

~~Repair~~ ~~Renewal~~ - New Service WO #7116

Location Comm 5-28-62

Date	Material	Amount	Total	Date	Amount	
	20' 6" Transite pipe @3.50			4-5-62	Deposit	250 00
	installed by cont.		70 00			7 74
4/9/62	Labor 42.60					257 74
4/16/62	" 59.13				20' 6" Transite	
4/17/62	" 6.63	108 36				
	10% O.H.	10 84	119 20			
	36' 6" Transite Pipe @ .78		28 08			
	1 6" Duplex Adapter		1 62			
	1 11 $\frac{1}{2}$ ° Transite Bend		5 10			
	1 22 $\frac{1}{2}$ ° Transite Elbow		2 24			
	3 Hrs. Town Shovel @ 6.50		19 50			
	4 Hrs. Trucking @ 3.00		12 00			
			187 74			
	PREVIOUS CHARGE		70 00			
			257 74			


DATE _____

TOWN OF LEXINGTON — BOARD OF PUBLIC WORKS

SEWER DIVISION

Sketch of Service Here

44

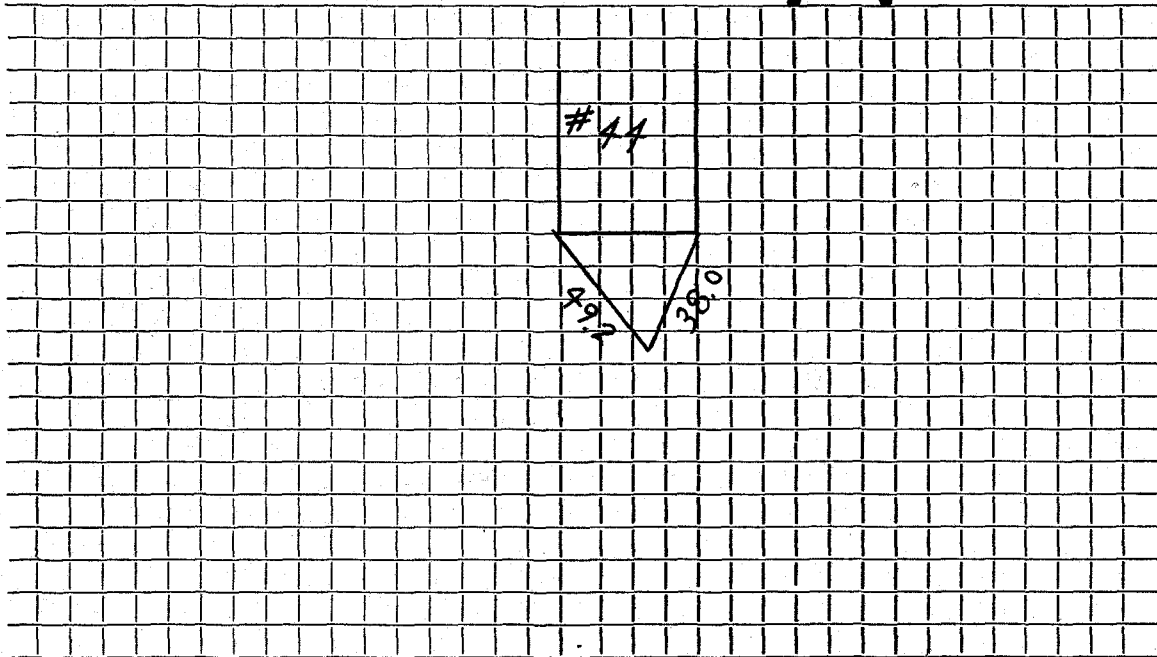

Connection made in Greenwood Street. Work completed

Remarks:

.....

.....