


DATE 10/27/89

TOWN OF LEXINGTON — BOARD OF PUBLIC WORKS
SEWER DIVISION

Sketch of Service Here

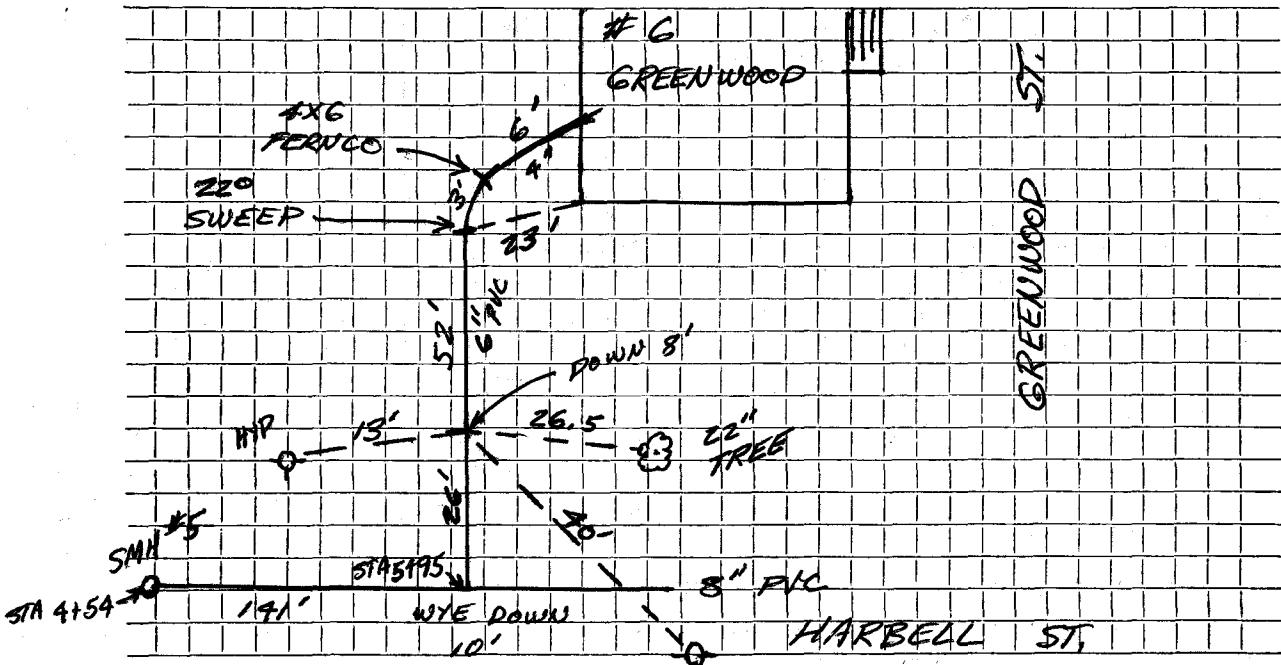

Connection made in HARBELL ST. Street. Work completed

Remarks: INSP. C.R.G.