

Name John F. Nolan

Service No. 23

Address # 4 GRIMES RD.

Location

Kind of Pipe A.C.

Size 6"

Size of Main 8"

~~Revised Estimate~~ New Service Valeri #4076

Location OCT 25 1982


Date	Material	Amount	Total	Date	Amount
4/20/75	41' A.C. @ 10.00		410 00	8-13-82	410 00
8/20/82	60' Sewer Pipe				
				4-28-75	
				41' 6" Transite	

DATE _____

TOWN OF LEXINGTON — BOARD OF PUBLIC WORKS

SEWER DIVISION

Sketch of Service Here **4**

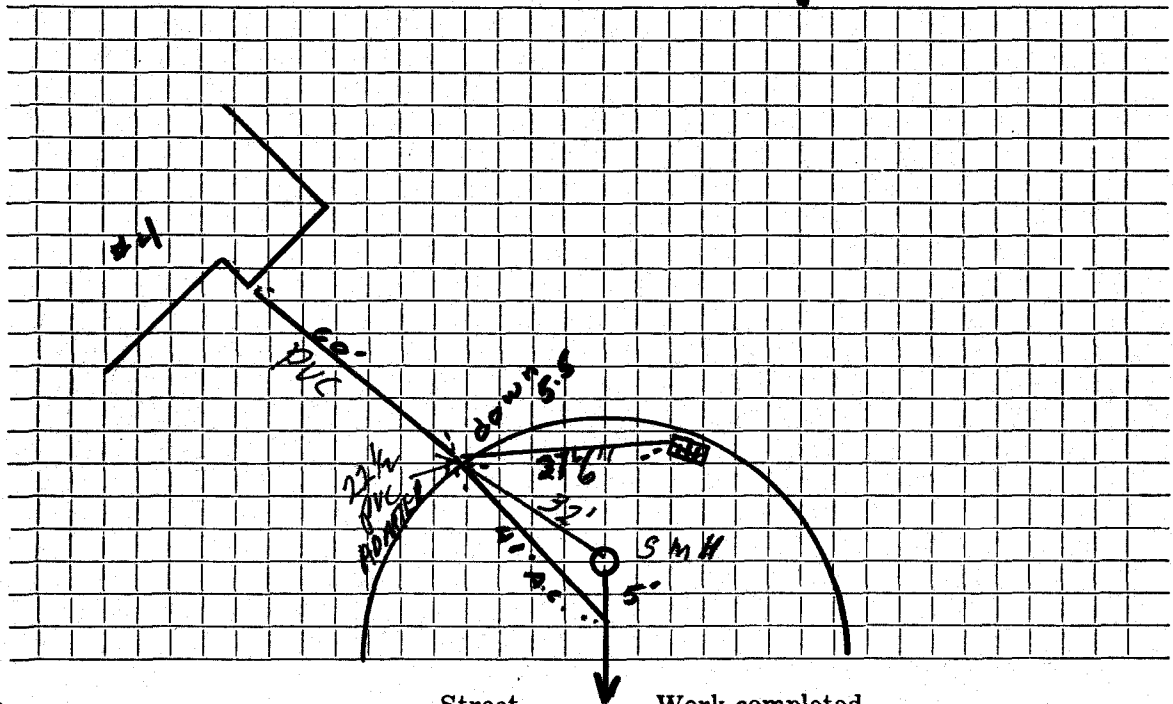

Connection made in Street. Work completed

Remarks:
.....
.....