

Name

Contractor: Michael C. Clery Inc.

Service No.

Address

151 Grove St

Location

Kind of Pipe

SDR35 PVC

Size

6"

Size of Main

Repair—Renewal—New Service

Location

Date

Material

Amount

Total

Date

Amount

1/8/19

6" Cleanout

6" PVC pipe


6" Fern Co

connect exist stub

DATE 1/8/19

TOWN OF LEXINGTON — BOARD OF PUBLIC WORKS
SEWER DIVISION

Sketch of Service Here

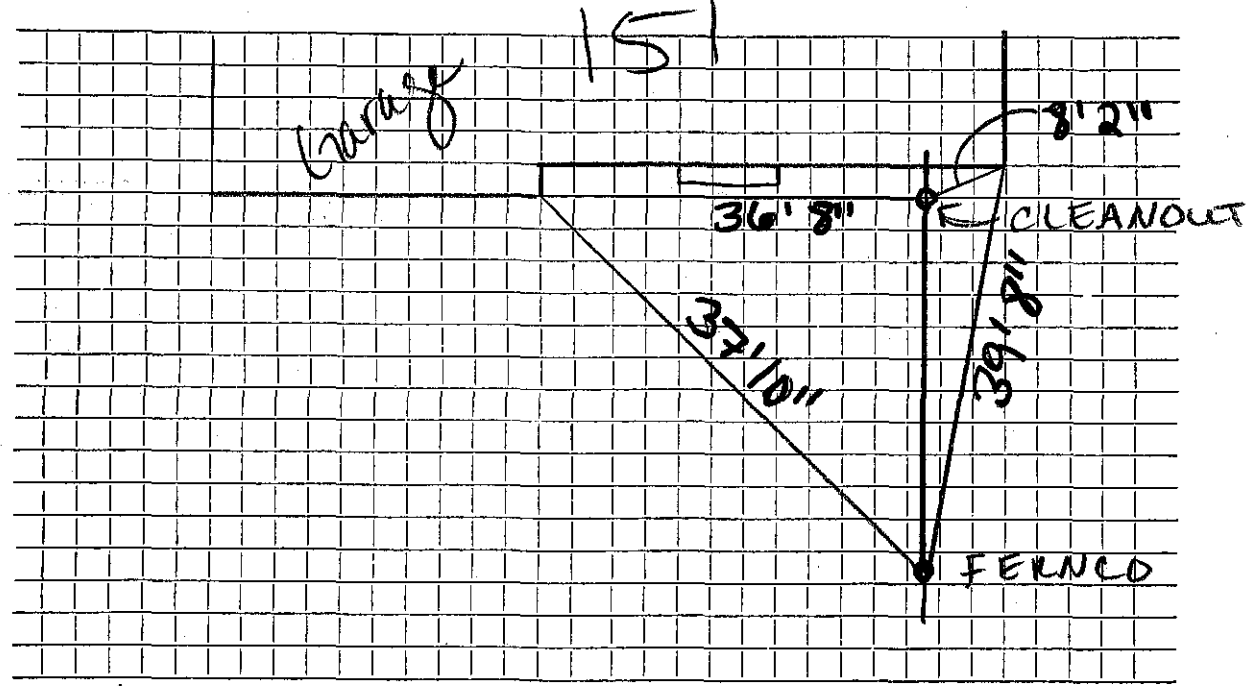

Connection made in Grove Street. Work completed

Remarks:
.....
.....