


DATE 12/31/18

TOWN OF LEXINGTON — BOARD OF PUBLIC WORKS
SEWER DIVISION

Sketch of Service Here

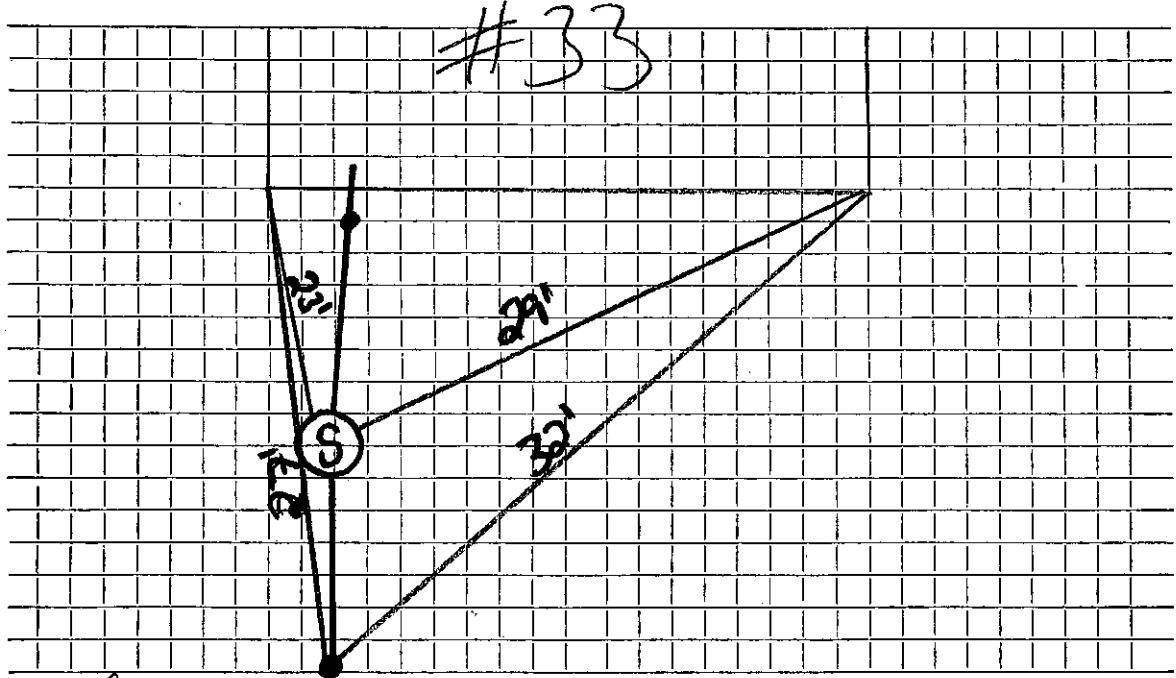

Connection made in Grove St Street. Work completed

Remarks:
.....
.....