

Name Clyde L. Hayne

Service No.

Address 102 Grove Street

Lot 3

Location

Kind of Pipe

Size

Size of Main

Repair—Renewal—New Service

Kirkland & Shaw #578


Location

Date	Material	Amount	Total	Date		Amount
1967	No Charge					
6-5-67	42' 6" Transite pipe					
	10' 4" Cast Iron Pipe					

DATE _____

TOWN OF LEXINGTON — BOARD OF PUBLIC WORKS
SEWER DIVISION

Sketch of Service Here **102**

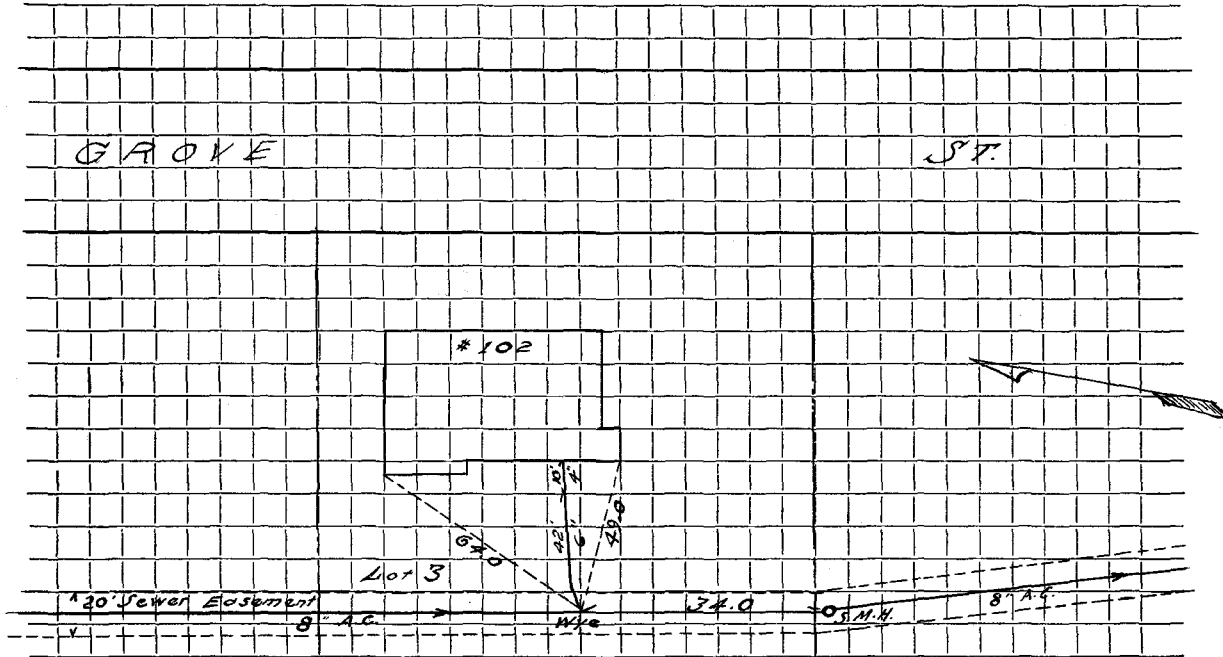

Connection made in Street. Work completed

Remarks:
.....
.....