

Name

Service No.

new files

Address

105 GROVE

Location

Kind of Pipe

PVC

Size

6"

Size of Main

8"

Repair—Renewal (New Service)

Location

Date

Material

Amount

Total

Date

Amount

1/26 89

PVC 6" 186'0"
22 1/2" BEND
8 X 6" SADDLE

DATE _____


TOWN OF LEXINGTON — BOARD OF PUBLIC WORKS

SEWER DIVISION

Sketch of Service Here

105

LOT # 133 A

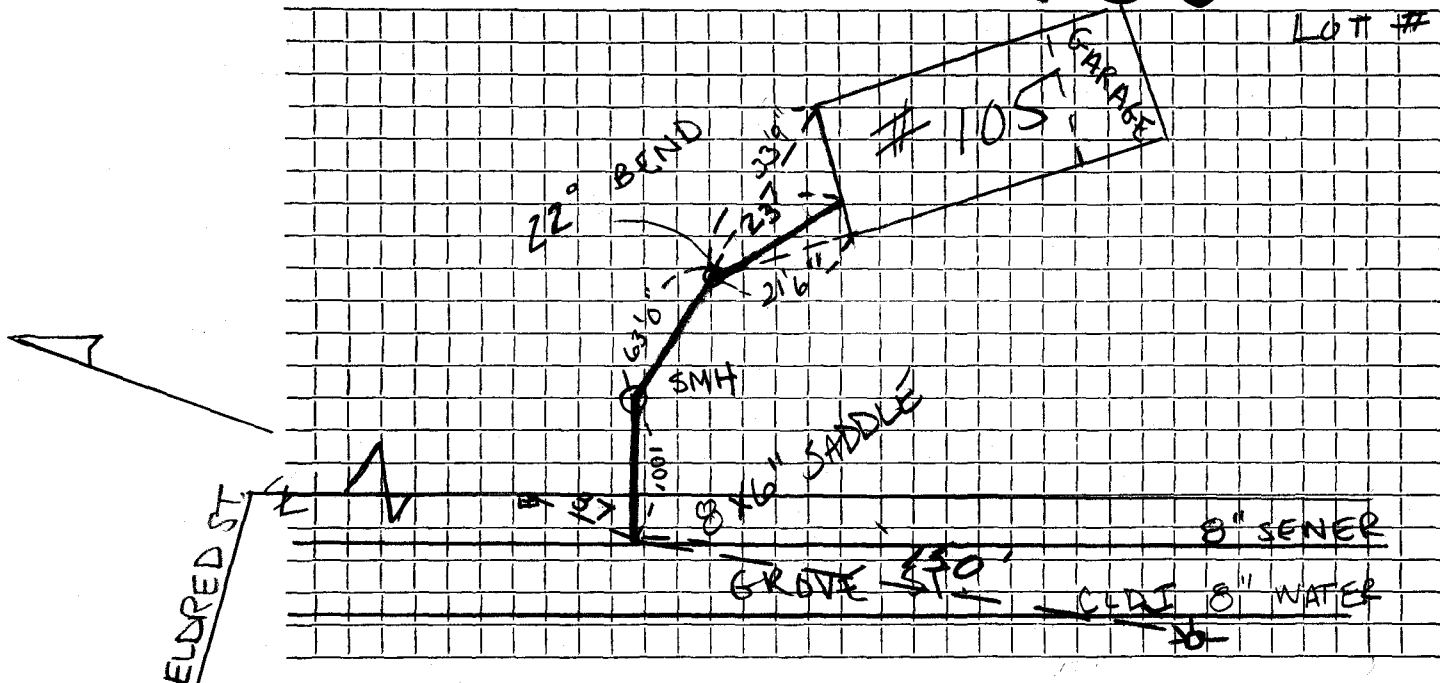

Connection made in Street. Work completed

Remarks:

.....


.....

DATE _____

TOWN OF LEXINGTON — BOARD OF PUBLIC WORKS

SEWER DIVISION

Sketch of Service Here

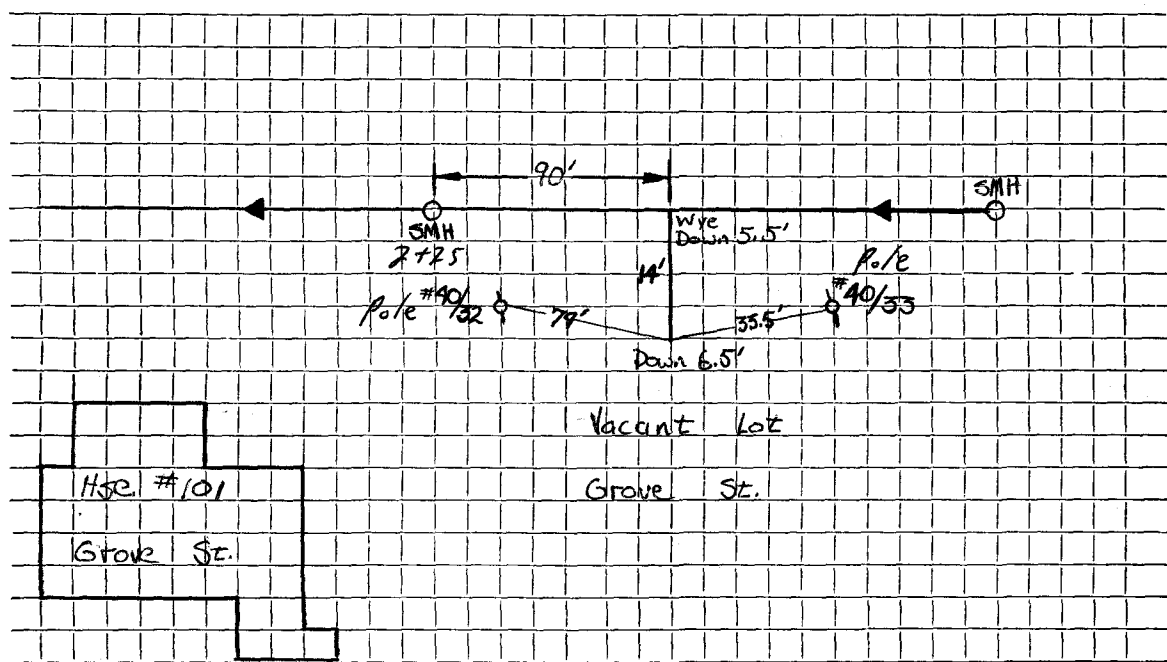

Connection made in Grove Street. Work completed

Remarks:
.....
.....