


DATE 3/14/96

TOWN OF LEXINGTON — BOARD OF PUBLIC WORKS
SEWER DIVISION

Sketch of Service Here **108**

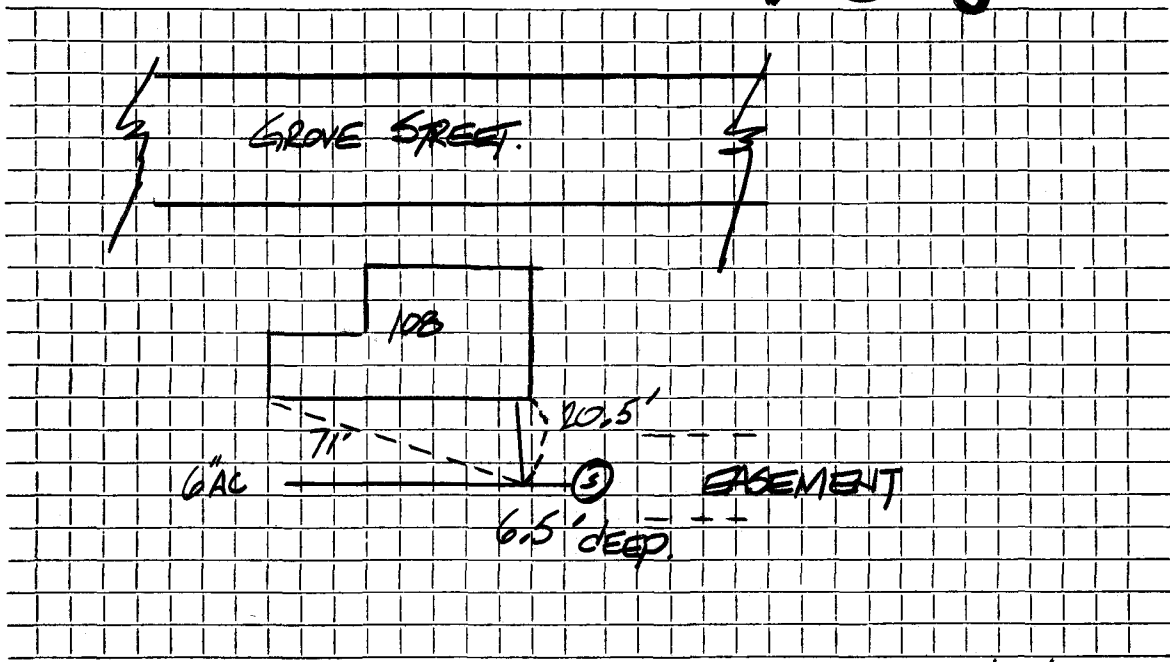

Connection made in GROVE STREET Street. Work completed 3/14/96

Remarks: PERMIT 745

CONTRACTOR J. M. LAUGHLIN WSP BOOK 96-1