

installed by 8-21-78 per plan

Name Joseph Lambert

Service No.

Address 110 Grove Street

Location

Kind of Pipe

Size

Size of Main

Repair—Renewal—New Service

Griecci #3077

Location

Date		Material	Amount		Total		Date		Amount	
8/21/78	263'	6" Transite Pipe								


DATE _____

TOWN OF LEXINGTON — BOARD OF PUBLIC WORKS

SEWER DIVISION

Sketch of Service Here

110

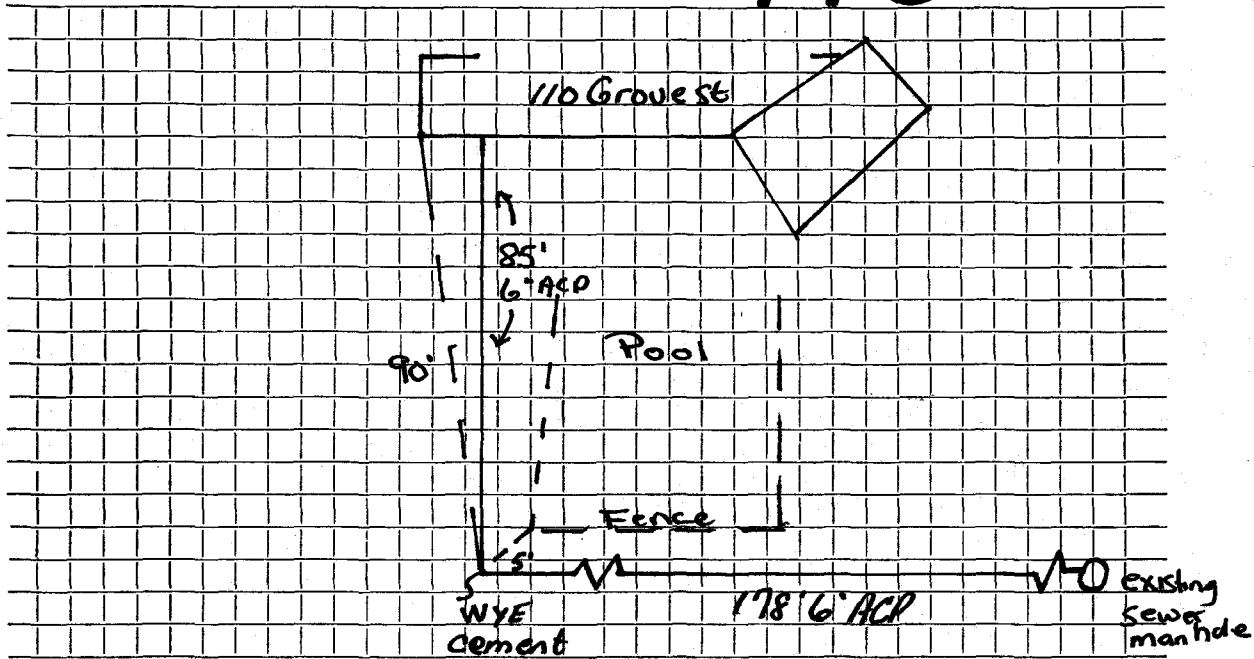

Connection made in Street. Work completed

Remarks:

.....
.....