

Name

Service No.

Address

115 Grove St

Location

Kind of Pipe

SDR35 PVC

Size

6"

Size of Main

Repair

Renewal

New Service

Location

Date

Material

Amount

Total

Date

Amount

7/28/20

4" PVC cleanout

4" x 6" FernCo

6" SDR35 PVC 410'


6" x 6" FernCo  
PVC to AC stub  
(depth @ 9')

DATE 7/28/2020

TOWN OF LEXINGTON — BOARD OF PUBLIC WORKS

SEWER DIVISION

Sketch of Service Here

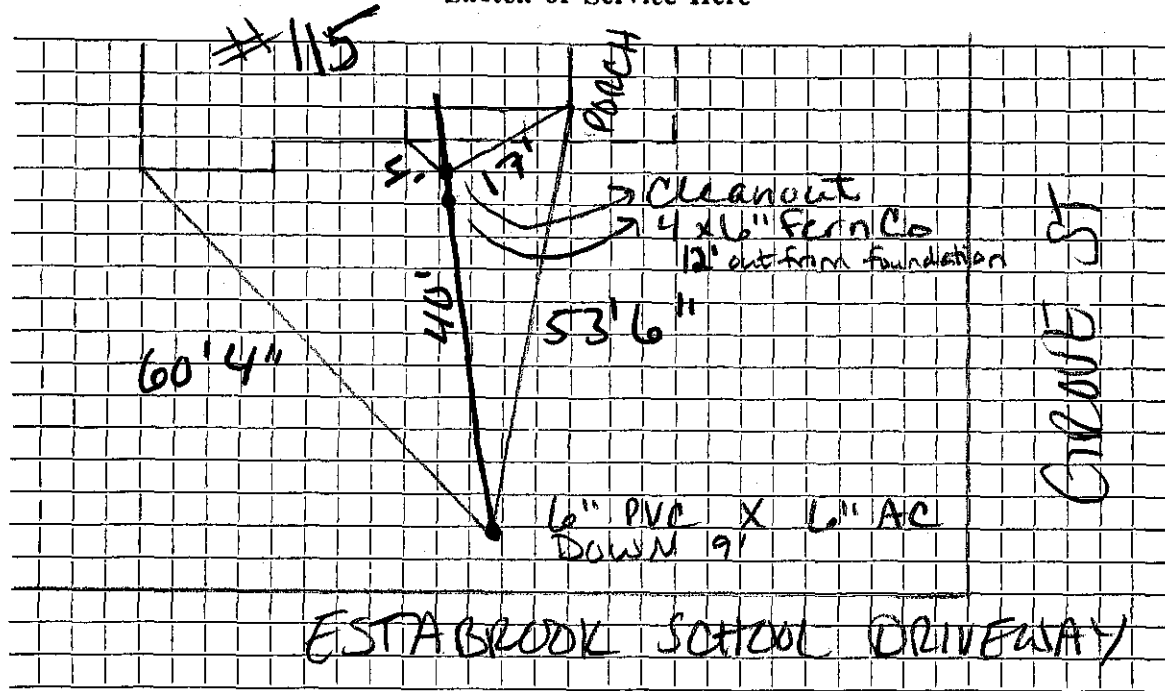

Connection made in Estabrook School Driveway

Work completed .....

Remarks: Stub depth @ 9'