

Name M. Louis Arin

Service No. 114

Address 118 Grove Street

Location

Kind of Pipe

Size

Size of Main DEC 18 1972

~~Repair~~ ~~Renewal~~ ~~XXXXXX~~ ~~XXXXXX~~

New Service

W.O. # 9989

Trebino Const. permit #2155

Location

~~7/6/81 030~~


Date	Material	Amount	Total	Date		Amount
8/14/72	Labor	117.78		8-24-72	Deposit.	400 00
8/15/72	"	157.04		4-5-73	Paid	25 00
9/22/72	"	45.58		3-13-73	Paid	25 00
	10% O.H.	32.04	352.44	4-11-73	Paid	25 00
6	5' x 6" Transite pipe @.89		4.45	4-3-77	Paid	31 17
6	Couplings 6" 1.78		10.68			506 17
1	90° Elbow		5.65			
1	Plug		2.38			
2	Ton Cold Patch @8.00		16.00			
2	Ton Hot Top @ 8.00		16.00			
2	4'x8'x 3/8" Plywood @5.60		11.20			
44'	6" x 4" Lumber @.48		21.12			
6½	hrs. Trucking @3.00		19.50			
5½	hrs. Shovel @ 6.50		35.75			
1	hr. Loader		4.00			
1	hr. Compressor		5.00			
1	hr. Roller		2.00			
			506.17			

DATE _____

TOWN OF LEXINGTON — BOARD OF PUBLIC WORKS
SEWER DIVISION

Sketch of Service Here

118

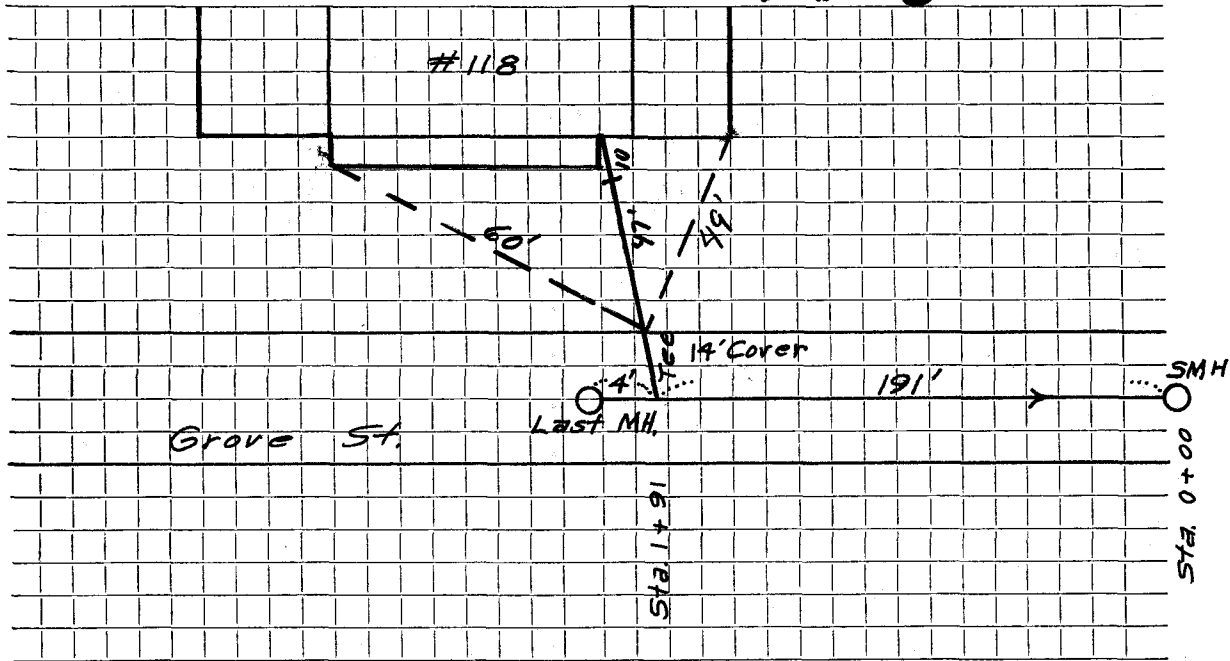

Connection made in Street. Work completed

Remarks:
.....
.....