

Name Bertrand E. Chatel

Service No. 54

Address 122 Grove Street

Location

Kind of Pipe

Size

Size of Main

~~RENEWAL~~—New ServiceSuburbinate #1385
W.O. # 6518

Location SEP 2 1969

Date	Material	Amount	Total	Date	Amount
6/30/69	Labor	86 20		6-16-69	Deposit 350 00
7/10/69	"	41 13	127 33	7-3-69	Refund 17 14
	10 % O.H.		12 73		332 86
	20' Transite pipe .88		17 60	6-30-69	
	1 5' Nipple		4 40		
	1 3' "		2 83	20' 6" Transite	
	1 1" "		1 21	1 6"-5' Nipple	
	1 90° Elbow		4 09	1 6"-3' Nipple	
	2 6" Coupling @ 1.09		2 18	1 6"-1' Nipple	
	1 Ton Cold Patch	5 50	17 40	1 6"-90° Elbow	
	3 " Hot top 5.80	17 40	10 50		
	3 1/2 Hrs. Trucking 3.00	10 50	75		
	1/2 " " 1.50	1 50			
	2 " Shovel 6.50	13 00			
	1 " Loader	4 00			
	1 " Compressor	5 00			
	3/4 " Roller 3.00	2 34			
	Trailer	2 00			
			232 86		
7-2-69	32' 6" Transite pipe				
	10' 4" Cast Iron Pipe				


DATE _____

TOWN OF LEXINGTON — BOARD OF PUBLIC WORKS

SEWER DIVISION

Sketch of Service Here

122

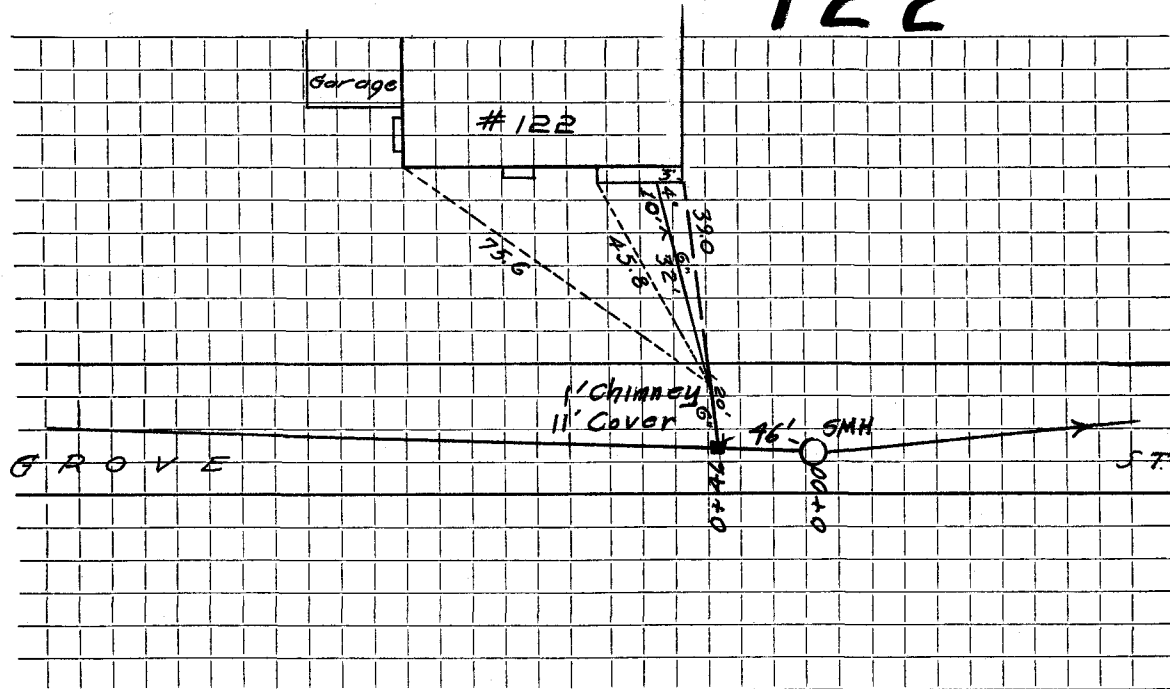

Connection made in Street. Work completed

Remarks:
.....
.....