

Name Donald Kourian

Service No. 59 A

Address 124 Grove Street

Location

Kind of Pipe

Size

Size of Main

Repair—Renewal—New Service Grant #648

Location

JUL 24 1967

Date	Material	Amount	Total	Date		Amount
1959	19 1/2" 6" Transite pipe		54.44	6-9-67	Deposit	54 44
1967	53' 6" Transite pipe					
					OUTSIDE W.O. 5653	
				8/8/77	Labor	115 28
					1 6" Transite Sleeve Adapter	2 35
					4' 6" Transite @ 1.75	7 00
					12 Red Bricks @.12	1 44
					1/2 Bag Cement	1 63
					2 Ton Cold Patch @ 13.50	27 00
					Hot Top Sidewalk 5' x 15'	49 98
					Hot Top Street 8' x 12'	64 02
				4-6-88	Respond & Measure job	268 70
				4-13-88	Ras 75	


DATE _____

TOWN OF LEXINGTON — BOARD OF PUBLIC WORKS

SEWER DIVISION

Sketch of Service Here

124 STA. 12+35.4

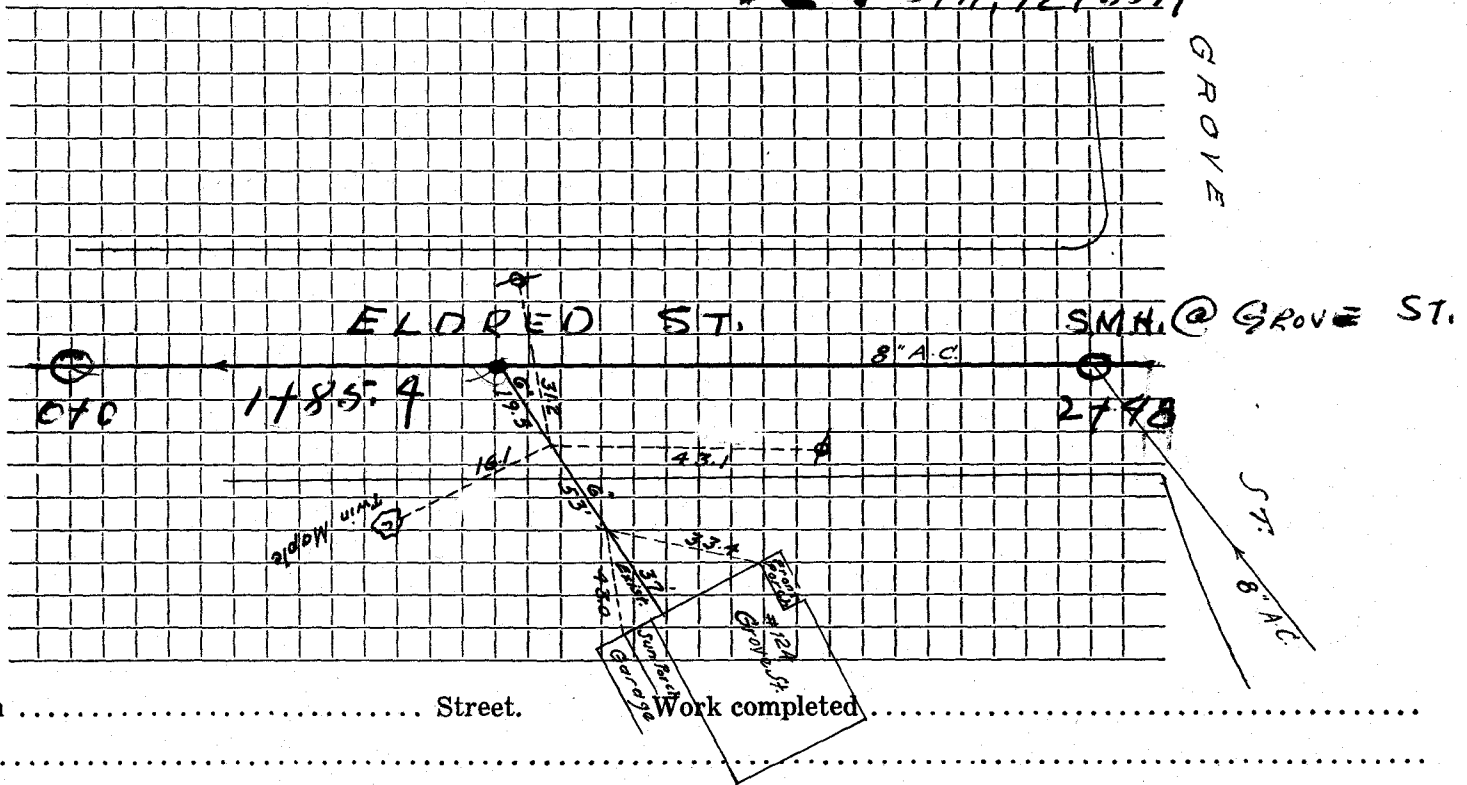

Connection made in Street.

Remarks:

.....

.....