


DATE _____

TOWN OF LEXINGTON — BOARD OF PUBLIC WORKS SEWER DIVISION

Sketch of Service Here

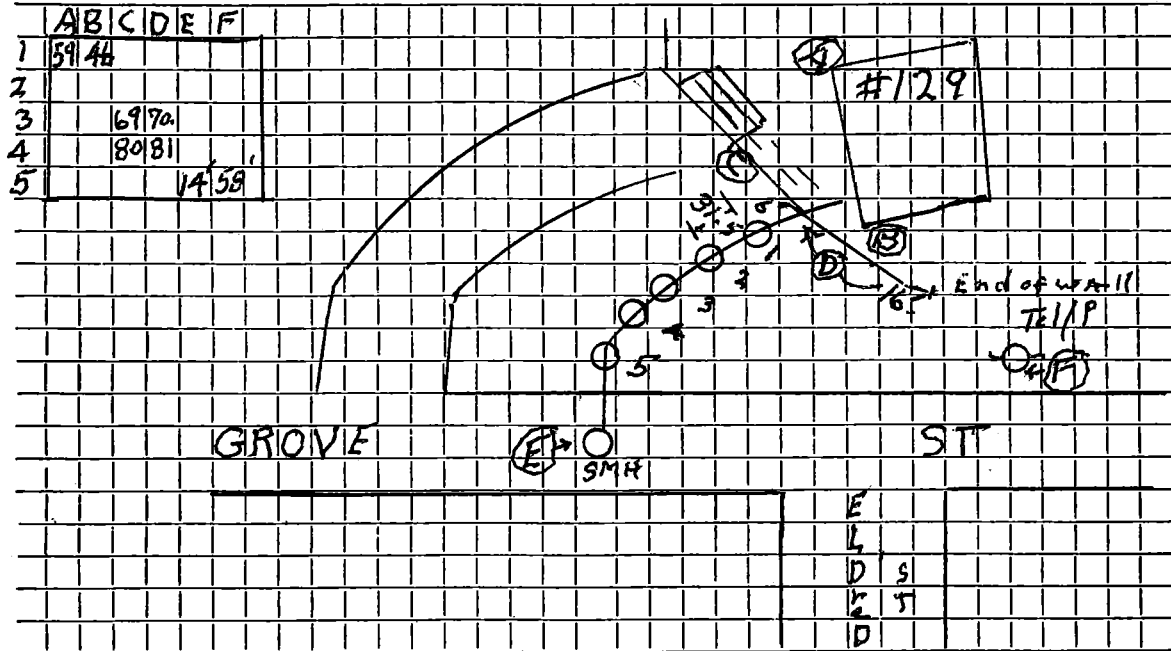

Connection made in M.H - Grove Street.

Work completed July 3, 1911 Insp. M.F. - D.P.

Remarks: 5 - Clean outs

.....
.....
.....